

Sunflower  
A 30  
8-12-80


MISSISSIPPI  
BOARD OF WATER COMMISSIONERS  
416 North State Street  
Jackson, Mississippi 39201

GW 4825  
NW/NW, Sec. 8  
Elev. 140  
**CODED**


WATER WELL DRILLERS LOG

8/12/80 date well completed  
Dyer firm name  
Sunflower county well located

LANDOWNER:	description of formations encountered	from	to
E.T. SHURDEN PARHAM, MS (mailing address)	Clay Fine Sand Sand	0 28 38	28 38 48
WELL LOCATION: sec. 10 T. 24 N. R. 4 E S. 5 5 miles W of Parham (distance) (direction) (nearest town)	Sand + Gravel	48	113
WELL PURPOSE: Domestic (home, irrigation, municipal, industrial)	<b>CODED</b>		
WELL COMPLETION DATA: (1) diameter (inches) 16 (2) total depth (feet) 113 (3) static water level (feet) 20' below top of ground. (4) casing Steel 113' (size) 16" if telescopic see back. (5) screen 40' 73' (length) (depth to top) (size) 16" Steel (material) (6) pump 60 3000 (HP) (yield gpm) Diesel (type power) (7) electric log (yes or no) (organization running log) (8) how well bottom plugged plate			

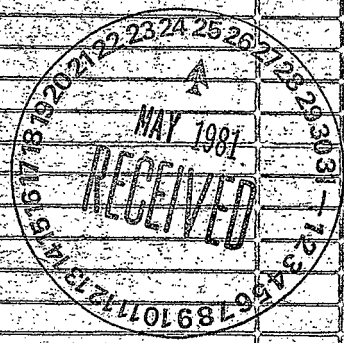

DRILLERS REMARKS:

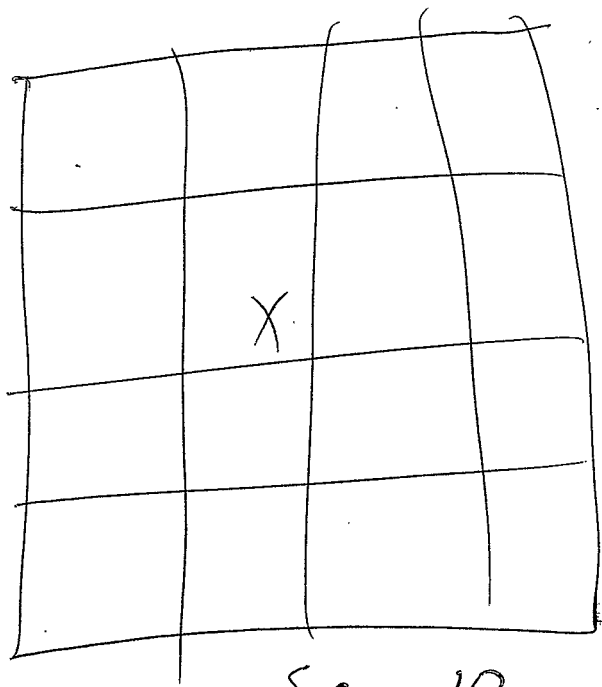

Sec 10