

MISSISSIPPI DEPARTMENT OF NATURAL RESOURCES  
Bureau of Land and Water Resources

Southport Mall

GW 42526

P.O. Box 10631

SW/SE, Sec. 18

Jackson, Mississippi 39209

Elev. 145

WATER WELL DRILLERS LOG

A35  
Sunflower Co  
6-26-84

CODED

6-62-84  
date well completed

J + K Irrigation Well  
firm name

Sunflower  
county well located

LANDOWNER:  
Joe Carpenter  
(mailing address)

description of formations encountered	from	to
CLAY	0	41
KIMBERLY SAND	41	55
SANDY SAND	55	107

WELL LOCATION:  
18 sec 31 T 24 N 23 S R 4 E W  
8 miles NW of Drew  
(distance) (direction) (nearest town)

WELL PURPOSE:  
(home, irrigation, municipal, industrial)

WELL COMPLETION DATA:

(1) diameter (inches) 8

(2) total depth (feet) 107

(3) static water level (feet) 28' below top of ground.

(4) casing PVC 67' (material) (depth)  
8" (size) if telescope see back.

(5) screen 40' 67' (length) (depth to top)  
8" (size) PVC (material)

(6) pump 20 (HP) 1200 (yield gpm)  
electric (type power)

(7) electric log no (yes or no)  
(organization running log)

(8) how well bottom plugged cap

CODED

DEPT. OF NATURAL RESOURCES  
BUREAU OF LAND & WATER RESOURCES


JUL 12 1984

RECEIVED

DRILLERS REMARKS:

If well telescopes please sketch and show depths.

GROUND LEVEL

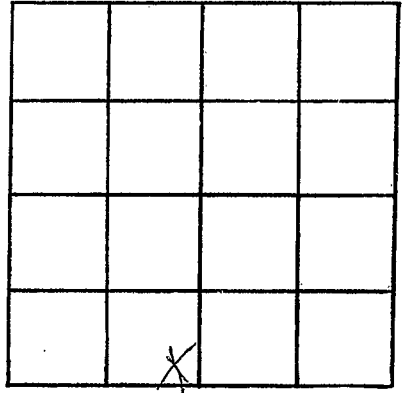

SECTION 31

Please indicate well location X.

ADDITIONAL INFORMATION

If more than one screen,  
show locations of each on sketch.