

MISSISSIPPI DEPARTMENT OF NATURAL RESOURCES

Bureau of Land and Water Resources

Southport Mall

P.O. Box 10631

Jackson, Mississippi 39209

WATER WELL DRILLERS LOG

CODED

A36
Sunflower
9-15-84

Gw 4604

SE/SW, Sec. 4

Elev. 146

9/84 date well completed

Powell Irrigation firm name

Sunflower county well located

LANDOWNER:
David MANKER

(mailing address)

description of formations encountered	from	to
CLAY	0	20
Fine + med SAND	20	50
Coarse SAND + GRAVEL	50	100

WELL LOCATION:
sec. 4 T 24 N R 4 E
1 1/2 miles W of BALZEE
(distance) (direction) (nearest town)

WELL PURPOSE: IRRIGATION
(home, irrigation, municipal, industrial)

WELL COMPLETION DATA:

(1) diameter (inches) 16

(2) total depth (feet) 100

(3) static water level (feet) 30 below top of ground

(4) casing Steel 60 (material) (depth)
(size) If telescope see back.

(5) screen 40 60 (length) (depth to top)
16 Steel (size) (material)

(6) pump 40 1500 (HP) (yield gpm)
Diesel (type power)

(7) electric log NO (yes or no)
(organization running log)

(8) how well bottom plugged: Steel Plate

DRILLERS REMARKS:


DEPT. OF NATURAL RESOURCES
BUREAU OF LAND & WATER RESOURCES

NOV 29 1984

RECEIVED

If well telescopes please sketch and show depths.

GROUND LEVEL

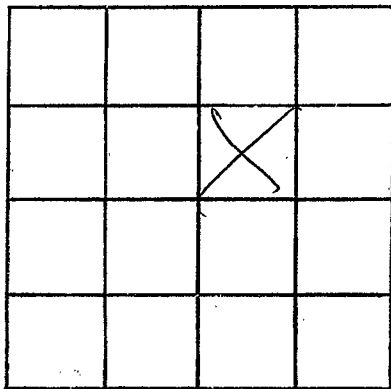

SECTION 4

Please indicate well location X.

ADDITIONAL INFORMATION

If more than one screen,
show locations of each on sketch.