

MISSISSIPPI DEPARTMENT OF NATURAL RESOURCES

Bureau of Land and Water Resources

COUNTY WELL LOCATED <i>Sumner</i>	
WELL NUMBER <i>A 41</i>	CODED
DATE WELL COMPLETED <i>6/88</i>	

PERMIT NUMBER
NAME OF DRILLING FIRM <i>Howell Drilling Inc</i> <i>Rt 2 Box 200</i> <i>Chickadee MS</i>

CODED

P.O. Box 10631
Jackson, Mississippi 39209
WATER WELL DRILLERS LOG

NAME & MAILING ADDRESS OF LANDOWNER <i>Adonadae</i> <i>Shelby, MS</i>			
WELL LOCATION: SEC	TOWNSHIP	RANGE	
<i>2</i>	<i>24</i>	<i>N</i>	<i>4 E</i>
DISTANCE		DIRECTION	NEAREST TOWN
<i>1</i> Miles		<i>E</i>	<i>BALTZER</i>
OTHER LANDMARK			
WELL PURPOSE: Home <u>Irrigation</u> Municipal, Industrial, Fish Pond, etc.			

PUMP DATA		
PUMP TYPE (Circle One): Submersible, <u>Turbine</u> Jet Flowing Well, Other (Describe) _____		
POWER TYPE (Circle One): Electric, Tractor, <u>Diesel</u> , Gasoline, Butane, Other (Describe) _____		
Pump Capacity (GPM) <i>3000</i>	No. of Stages <i>1</i>	Setting Depth <i>60'</i> FT.
PUMP TEST		
Well yielded <i>3000</i> GPM with a drawdown of _____ ft. after _____ hours of pumping		

WELL DATA		
Well Depth <i>110'</i>	Casing Diameter (In.) <i>16"</i>	Casing Length (Ft.) <i>70'</i>
Type of Casing <i>STEEL</i>	Hole Depth <i>110'</i>	Depth to Static Water Level <i>26'</i>
TYPE OF COMPLETION: (Circle One or More): <u>Gravel Packed</u> Underreamed, Telescoped, Natural Development, Open Hole, Other		
Top of Lap Pipe or Reduction in Casing FEET IF TELESCOPED OR MORE THAN ONE SCREEN: USE BACK PAGE		

LOG DATA	
TYPE OF LOG RUN (Circle One): Electric, Gamma Ray, Density, Sonic, Neutron, Other (Describe) _____	
Name of Organization Running Log	

SCREEN DATA		
Diameter - inches <i>16"</i>	Length - Feet <i>40'</i>	Slot Size - Inches <i>.030</i>
Screen Type <i>Steel</i>		Depth to Bottom Feet <i>110'</i>

GEOLOGIC DATA (Office Use Only)			
Surface Elev.	Geologic Unit	Unit Thickness	Depth to Top
Subs. SWL	Date	Analysis	Aquifer Test


Driller's Remarks

DESCRIPTION OF FORMATIONS ENCOUNTERED	FROM	TO	FORMATION(S) (continued) FROM TO
<i>Clay</i>	<i>0</i>	<i>20</i>	<div style="font-size: 2em; opacity: 0.5; transform: rotate(-15deg);"> RECEIVED SEP 22 1988 Department of Natural Resources Bureau of Land & Water Resources </div>
<i>fine sand</i>	<i>20</i>	<i>50</i>	
<i>Coarse sand + gravel</i>	<i>50</i>	<i>100</i>	

IF MORE SPACE IS NEEDED, USE BACK

If well telescopes please sketch and show depths.

GROUND LEVEL

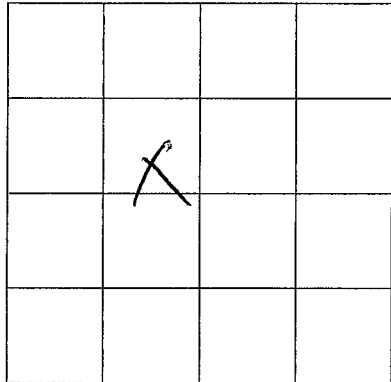

SECTION 2

Please indicate well location X.

ADDITIONAL INFORMATION

Multiple horizontal lines for additional information.

If more than one screen, show location of each on sketch.