

MISSISSIPPI DEPARTMENT OF NATURAL RESOURCES

Bureau of Land and Water Resources

Southport Mall

P.O. Box 10631

107 A 0873

Jackson, Mississippi 39209

WATER WELL DRILLERS LOG

Sunflow
A 43

CODED

Aug 1988 SK Cook Drilling Sunflow
 date well completed firm name county well located

LANDOWNER:	description of formations encountered	from	to
<u>Gandy & Son Farm</u>			
<u>RT 1 Box 55 Pleasant</u>	<u>clay</u>	<u>top</u>	<u>25</u>
<u>78732 (mailing address) Miss</u>	<u>3' sand</u>	<u>35'</u>	<u>100</u>
<u>WELL LOCATION:</u>	<u>very little gravel</u>		
sec. <u>12 T. 24 N</u> R. <u>4 E</u> S. <u>4 W</u>			
<u>6</u> miles <u>NE</u> of <u>Cleora</u>			
(distance) (direction) (nearest town)			
<u>WELL PURPOSE:</u> <u>fish</u>			
(home, irrigation, municipal, industrial)			
<u>WELL COMPLETION DATA:</u>			
(1) diameter (inches) <u>8</u>			
(2) total depth (feet) <u>100</u>			
(3) static water level (feet) <u>24</u> below above top of ground.			
(4) casing <u>PVC</u> , <u>60</u> (material) (depth)			
<u>8'</u> (size) if telescope see back.			
(5) screen <u>40</u> , <u>60</u> (length) (depth to top)			
<u>8</u> , <u>PVC</u> (size) (material)			
(6) pump <u>1.0</u> , <u>1000</u> (HP) (yield gpm)			
<u>2hp</u> (type power)			
(7) electric log _____ (yes or no)			
(organization running log)			
(8) how well bottom plugged _____			
<u>DRILLERS REMARKS:</u>			


RECEIVED

FEB 24 1989

Department of Natural Resources
 Bureau of Land & Water Resources

If well telescopes please sketch and show depths.

GROUND LEVEL

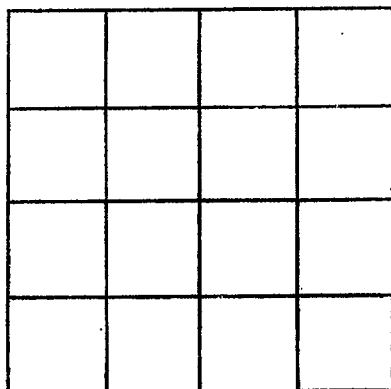

SECTION 17

Please indicate well location X.

ADDITIONAL INFORMATION

If more than one screen,
show locations of each on sketch.