

# State Well Report

## Part 1

Mississippi Department of Environmental Quality  
Office of Land and Water Resources  
P.O. Box 10631  
Jackson, MS 39289-0631  
(601)961-5210  
(601)354-6938 (fax)

### For Office Use Only:

Aquifer: \_\_\_\_\_  
Well #: A-52  
L. S. Elevation: \_\_\_\_\_  
E-log #: \_\_\_\_\_

County: Sunflower  
Permit #: \_\_\_\_\_  
Driller: Willie L. Bryant  
Date drilling completed: 11-5-07

State Law requires that this report be prepared by the driller in detail and filed with the Department within 30 days of completion of drilling of the well.

Well Owner Information	Well Location
Owner Name: <u>Mt. Olive Baptist Church</u>	Latitude: <u>33° 59' 15" N</u> Longitude: <u>090° 35' 66" W</u>
Mailing Address: <u>40 Willie A. Palmer</u>	Method of Lat/Long (circle one): Conventional Survey, <u>39</u>
<u>319 Mississippi Ave.</u>	USGS quad, <u>Hand-held GPS</u> , Survey-grade GPS <input checked="" type="checkbox"/>
<u>Clarksdale MS 38614</u>	1/4 Sec <u>3</u> Twn <u>24N</u> Rng <u>4W</u>
City State Zip Code	Distance Direction Nearest Town
Telephone No. <u>(662) 624-6990</u>	<u>12</u> Miles <u>West</u> of <u>Drew</u>

### Well Data

Purpose of Well (circle one) Home Industrial Public Supply Irrigation Fish Culture Other: Church

Date well drilling started: 11-5-07 Date well drilling completed: 11-5-07

If flowing, method of flow regulation: Valve \_\_\_\_\_ Other (describe) \_\_\_\_\_

Static Water Level: 31' feet above or below (circle one) land surface Date measured: 11-5-07

Method of Measurement (circle one) steel tape electric tape air line other: Rope & weight

Hole depth: 100' Well depth: 100' Well grouted to a depth of 12 feet

Type of grout (circle one): Cement Bentonite Mix

Casing length: 90 feet Casing diameter: 4 inches Type of casing: PVC SCH 40

Screen length: 10 feet Screen diameter: 4 inches Type of screen: PVC Slotted

Screen slot size: .013 inches Setting depth: From 90 feet to 100 feet

Type of completion (circle all applicable): Gravel packed Underreamed Telescoped Open hole Natural Development

Other (describe): \_\_\_\_\_

Top of lap pipe or reduction in casing: 0 feet. If telescoped or more than one screen, describe on back of page

Logs run (circle all applicable): No log run Electric Gamma Ray Density Sonic Neutron Other: \_\_\_\_\_

Name of organization running log(s): \_\_\_\_\_


I certify that the well was drilled, constructed, and completed in accordance with all applicable requirements of the Mississippi Department of Environmental Quality and/or the Mississippi Department of Health regulations and state laws.

Willie L. Bryant 0-0639 Willie L. Bryant  
Print Name of Water Well Contractor and License No. Signature of Water Well Contractor

RECEIVED  
DEC 06 2007  
BY: OLWR

If well telescopes please sketch below and show depths.


Ground Level

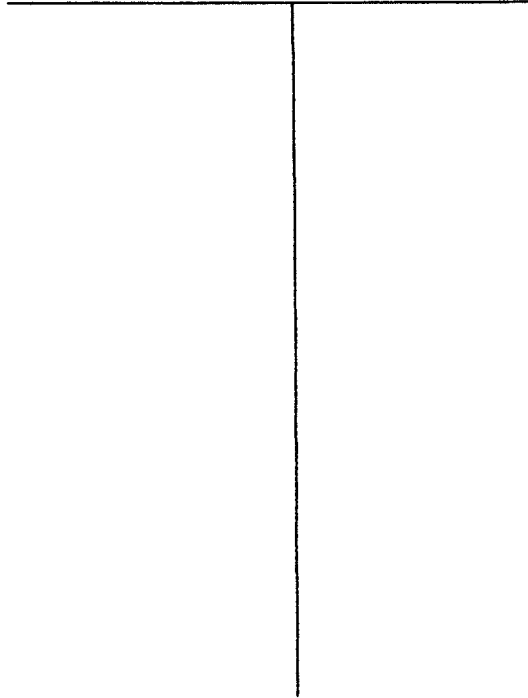

Description of Formations Encountered	From	To
Clay & Brown sand	0	20
Brown sand & clay	20	40
Clay & med. sand	40	60
Med. & coarse sand	60	80
Coarse sand & gravel	80	100

If more than one screen, show location of each on sketch

Sketch the property layout and include the following: 1) the well location; 2) any permanent structures on the property that may aid in locating the well; 3) any roads, power lines, or other items that may aid in locating the property and the well; 4) indicate direction.

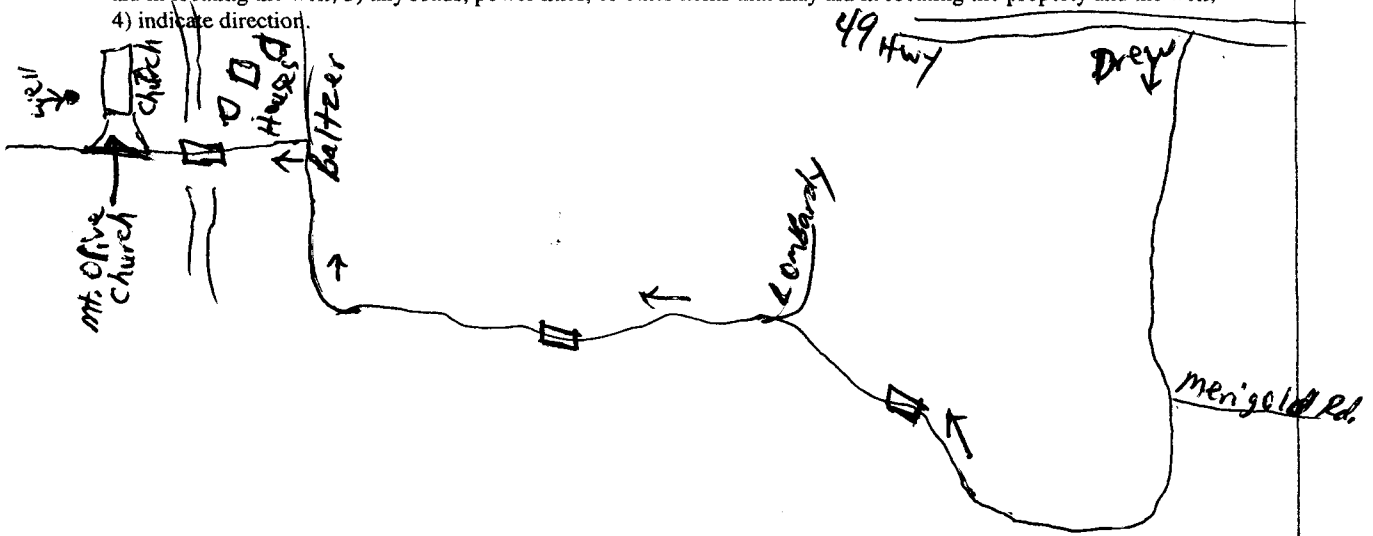

Landowner Name: Mt. Olive Baptist Church - C/O Willie A. Palmer

Willie L. Bryant  
Signature of Water Well Contractor

RECEIVED  
DEC 06 2007  
BY: OLWR

# STATE WELL REPORT

## Part 2

**Pump Installer's Completion Report**  
 Mississippi Department of Environmental Quality  
 Office of Land and Water Resources  
 P.O. Box 10631  
 Jackson, MS 39289-0631  
 (601)961-5210  
 (601)354-6938 (fax)

County: Sunflower  
 Permit #: \_\_\_\_\_  
 Driller: Willie L. Bryant  
 Date completed: 11-10-07

For Office Use Only:

Aquifer: \_\_\_\_\_  
 Well #: A-52  
 Elevation: \_\_\_\_\_

**This report should be prepared by the pump installer in detail and filed with the Department within 30 days of the installation of pump.**

Well Owner Information	Well Location
Owner Name: <u>Mt. Olive Baptist Church</u>	Latitude: <u>33°59.15' N</u> Longitude: <u>090°35.66' W</u>
Mailing Address: <u>C/O Willie A. Palmer</u> <u>319 Mississippi Ave.</u> <u>Clarksdale MS 38614</u> City State Zip Code	Method of Lat/Long (circle one): Conventional Survey, USGS quad, <u>(Hand-held GPS)</u> Survey-grade GPS
Telephone No. <u>(662) 624-6990</u>	_____ 1/4 _____ 1/4 Sec <u>3</u> Twn <u>24N</u> Rng <u>4W</u>
	Distance Direction Nearest Town <u>12</u> Miles <u>west</u> of <u>Drew</u>

Pump Type Circle one	Power Type Circle one
Air Lift Jet <u>Submersible</u>	Diesel Engine Gasoline Engine Natural Gas
Bucket Piston Turbine	<u>Electric Motor</u> Hand Tractor PTO
Centrifugal Rotary Flowing Well	Windmill Other (specify): _____
Other (specify): _____	Horse Power Rating of Motor: <u>3/4</u> HP
Date Pump Installed: <u>11-5-07</u>	Setting Depth: <u>60</u> feet
Rated Pump Capacity: <u>12</u> Gallons Per Minute	Number of Stages: <u>8</u>

Pump Test Data	Method of Measuring Water Level Circle one
Date Well Tested: <u>11-10-07</u>	Air Line Electric Measuring Line Steel Tape
Static Water Level (A): <u>31</u> Feet Below Land Surface	Other (specify): <u>Rope &amp; weight</u>
Pumping Water Level (B): <u>33</u> Feet Below Land Surface	For flowing well, measured shut in head: _____ feet
Drawdown [(B) - (A)]: <u>2</u> Feet Below Land Surface	Well yielded <u>12</u> GPM with a drawdown of
Test Pumping Rate: <u>12</u> Gallons Per Minute	<u>2</u> feet after <u>4</u> hours of pumping
Duration of Pump Test (minimum 4 hours): <u>4</u> hours	

I HEREBY CERTIFY that the above statements are true to the best of my knowledge.

Willie L. Bryant 0-0639 Willie L. Bryant  
 Print Name of Pump Installer and License No. (if applicable) Signature of Pump Installer

RECEIVED  
 DEC 06 2007  
 BY: OLWR