

MISSISSIPPI DEPARTMENT OF NATURAL RESOURCES

Bureau of Land and Water Resources

Southport Mall

P.O. Box 10631

Jackson, Mississippi 39209

WATER WELL DRILLERS LOG

SUNFLOWER
MS 892 1204-6
2000

A

#1 date well completed 7-5-90 firm name PARCHMAN county well located Sunflower

LANDOWNER: State of Miss
1501 Walter Letter Bldg
Jackson Ms 39201
 (mailing address)

description of formations encountered	from	to
	<u>topsoil</u>	<u>0</u>
<u>clay</u>	<u>7</u>	<u>20</u>
<u>fine sand</u>	<u>20</u>	<u>65</u>
<u>coarse sand & rock</u>	<u>65</u>	<u>107</u>

WELL LOCATION:
 sec. 24 T 24 (N) R 04 E
3 miles west of Parchman
 (distance) (direction) (nearest town)


WELL PURPOSE: irrigation
 (home, irrigation, municipal, industrial)

WELL COMPLETION DATA:

- (1) diameter (inches) 16"
- (2) total depth (feet) 107'
- (3) static water level (feet) 19' below above top of ground.
- (4) casing steel, 67'
 (material) (depth)
 _____ if telescope see back.
 (size)
- (5) screen 40", 67'
 (length) (depth to top)
16", steel
 (size) (material)
- (6) pump 60, 3000
 (HP) (yield gpm)
Vertical
 (type power)
- (7) electric log _____
 (yes or no)

 (organization running log)
- (8) how well bottom plugged steel
plug


DRILLERS REMARKS:

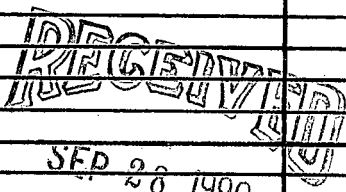

Department of Natural Resources
 Bureau of Land & Water Resources

If well telescopes please sketch and show depths.

GROUND LEVEL

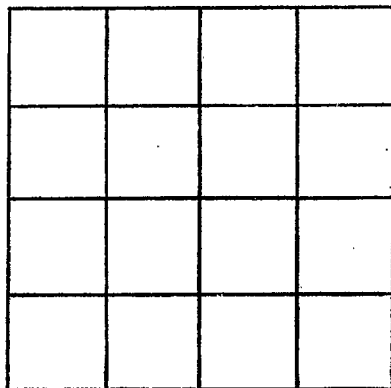

SECTION _____

Please indicate well location X.

ADDITIONAL INFORMATION

If more than one screen, show locations of each on sketch.