

B 27
7-26-64

WATER WELL DRILLERS LOG

CODED

Date: July 26, 1964, Driller: Robert E. Ratliff County: Merida
(Name)

(1) Owner of Land: A. J. Hill
(Name)
Rome, Miss
(Address)

(2) Location: 1/4, 1/4, Sec. 2 T29R3
_____ miles _____ of Rome
(distance) (direction) (Nearest Town)

(3) Topography: Hilly
(Hilly) (Flat) (Level)

(4) Purpose of Well: Domestic
(Domestic Irrigation
Municipal, Industrial, Other)

Description & Color of Materials Sand, Clay, Red Clay, Shell, etc.	Thick- ness Feet	Depth Feet
<u>Gravel</u>	<u>0</u>	<u>18</u>
<u>Sand & Shell</u>	<u>18</u>	<u>35</u>
<u>Gravel</u>	<u>35</u>	<u>60</u>
<u>Small Gravel</u>	<u>60</u>	<u>100</u>

Information upon completion of well:

(1) Diameter 4" inches. Plastic

(2) Total Depth 100 feet.

(3) Water Level 15 feet below top of ground.

(4) Cased to 100, Size 4"

(5) Screen: Size 4", Length 34'


(6) Were any formations sealed against pollution?
✓ yes, _____ no.

CODED

If YES depth of formation Cased

Why _____

Drillers Remarks: _____

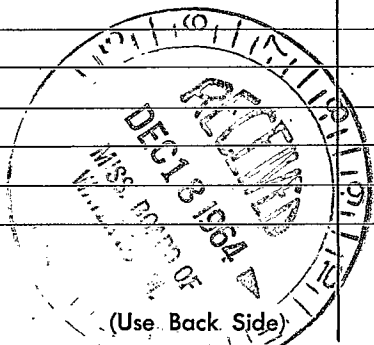

Well No. _____

1912

Faint, illegible text, possibly bleed-through from the reverse side of the page. The text is scattered across the page and is mostly illegible due to fading and low contrast.