

SUNFLOWER
B 32
7-8-72

MISSISSIPPI
 BOARD OF WATER COMMISSIONERS
 416 North State Street
 Jackson, Mississippi 39201

COPIED
 COPIED

WATER WELL DRILLERS LOG

7/8 date well completed 722 Otterwell & Lafayette Sunflower firm name _____ county well located

LANDOWNER:
C. H. Bourchfield
Drew - Miss.
 (mailing address)

WELL LOCATION:
 sec. 26 T 24 N R. 3 E
1 1/2 miles east of Greenville
 (distance) (direction) (nearest town)

WELL PURPOSE: Home
 (home, irrigation, municipal, industrial)

WELL COMPLETION DATA:

(1) diameter (inches) 4 1/2

(2) total depth (feet) 1080

(3) static water level (feet) 2 below above top of ground.

(4) casing galv. steel
 (material) (depth)

_____ if telescope see back.
 (size)

(5) screen 20 ft.
 (length) (depth to top)
2" stainless steel
 (size) (material)

(6) pump 1 20
 (HP) (yield gpm)
elec
 (type power)

(7) electric log No
 (yes or no)

_____ (organization running log)

(8) how well bottom plugged B.P. / blue

description of formations encountered	from	to
	<u>Loam soil</u>	<u>0</u>
<u>loam sand</u>	<u>23</u>	<u>83</u>
<u>sand & gravel</u>	<u>83</u>	<u>150</u>
<u>Clay</u>	<u>150</u>	<u>183</u>
<u>Shale & Clay</u>	<u>183</u>	<u>323</u>
<u>Shale</u>	<u>323</u>	<u>343</u>
<u>Blue colored shale</u>	<u>343</u>	<u>383</u>
<u>Sand</u>	<u>383</u>	<u>440</u>
<u>Shale & Sand</u>	<u>440</u>	<u>523</u>
<u>Sand shale & rock</u>	<u>523</u>	<u>603</u>
<u>Sand</u>	<u>603</u>	<u>800</u>
<u>Shale & sand</u>	<u>800</u>	<u>903</u>
<u>sand</u>	<u>903</u>	<u>1003</u>
	<u>1003</u>	<u>1083</u>



DRILLERS REMARKS: L

JUL 18 1972

MISS. BD. OF
 WATER COMMISSIONERS

If well telescopes please sketch and show depths.

GROUND LEVEL

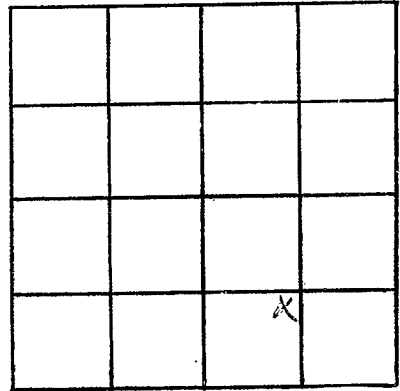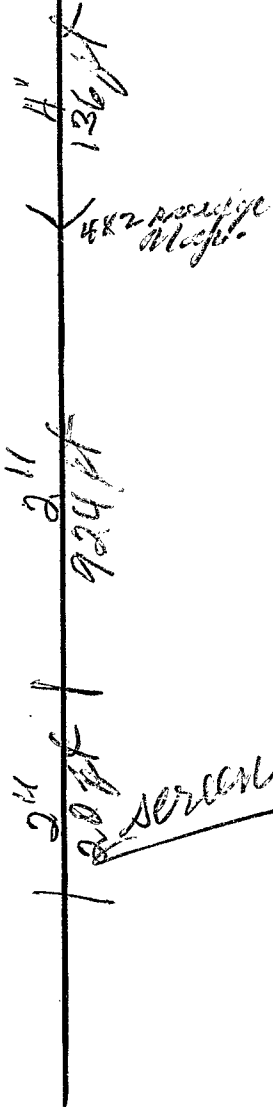

SECTION 26

Please indicate well location X.

ADDITIONAL INFORMATION

If more than one screen, show locations of each on sketch.