

SUNFLOWER

B35

9/75

E log # 63

MISSISSIPPI BOARD OF WATER COMMISSIONERS
416 North State Street
Jackson, Mississippi 39201

WATER WELL DRILLERS LOG

CODED

September 19 75
date well completed

Herndon Well & Supply, Inc.

Sunflower


firm name

county well located

LANDOWNER: Miss. Bldg. Comm. Medium Security, Penitentiary Parchman, MS (mailing address)	description of formations encountered	from	to
WELL LOCATION: sec. <u>29</u> T <u>24</u> N R <u>3</u> SE <u>W</u> Inside Compound <u> </u> miles of <u> </u> of <u>Parchman</u> (distance) (direction) (nearest town) WELL PURPOSE: (home, irrigation, municipal, industrial) WELL COMPLETION DATA: (1) diameter (inches) <u>10 x 6</u> (2) total depth (feet) <u>1100</u> (3) static water level (feet) <u>24</u> below top of ground. (4) casing <u>Steel</u> <u>1040</u> (material) (depth) <u>10"</u> If telescope see back. (size) (5) screen <u>60</u> <u>1040</u> (length) (depth to top) <u>6</u> <u>Stainless Steel</u> (size) (material) (6) pump <u>40</u> <u>360</u> (HP) (yield gpm) <u>Elec.</u> (type power) (7) electric log <u>Yes</u> (organization running log) <u>USGS</u> (organization running log) (8) how well bottom plugged <u>6 1/2" BWV</u>	Clay	0	18
	Fine Sand	18	60
	Small Gravel & Sand	60	100
	Gravel and Sand	100	150
	Clay - Sandy	150	358
	Tough Clay	358	475
	Fine Sand	475	510
	Clay	510	540
	Clay - Sand Streaks	540	560
	Fine Sand	560	600
	Clay	600	938
	Fine Sand	938	962
	Clay	962	990
	Gummy Clay	990	1040
	Fine Sand	1040	1100
Shale Streaks gummy Clay and Sand	1100	1180	
CODED MISS. BOARD OF WATER COMMISSIONERS SEP 22 1975			
DRILLERS REMARKS:			

If well telescopes please sketch and show depths.

GROUND LEVEL

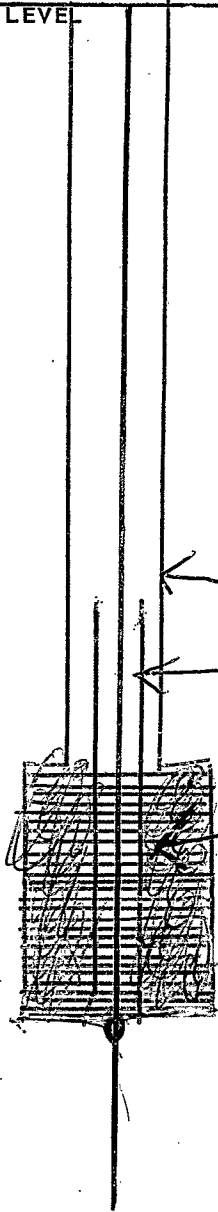

x			

SECTION 29

Please indicate well location X.

ADDITIONAL INFORMATION

1040 ft 10" casing
85 ft 6" lap pipe

60 ft 6" slit
7 yds gravel

If more than one screen, show locations of each on sketch.