


Sunflower
 AB 36
 5-67

MISSISSIPPI
 BOARD OF WATER COMMISSIONERS

416 North State Street
 Jackson, Mississippi 39201

WATER WELL DRILLERS LOG

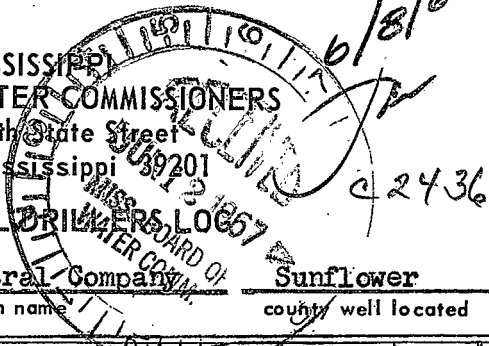

May 29, 1967 Layne-Central Company Sunflower
 date well completed firm name county well located

LANDOWNER: Mississippi State Penitentiary
 Camp 6

description of formations encountered	from	to
Top soil	0	6
Fine silky sand	6	22
Coarse sand	22	87
Coarse sand, pea gravel	87	142
Coarse white sand	142	325
Shale, hard	325	368
Shale, sandy strks.	368	485
Fine sand	485	502
Sand	502	524
Clay, fine sand	524	541
Fine sand	541	566
Sand	566	620
Clay	620	628

Parchman, Mississippi
 (mailing address)

WELL LOCATION:
 sec. 36 T. 24 N. R. 9 E. S. 3
 _____ miles _____ of Parchman
 (distance) (direction) (nearest town)

WELL PURPOSE: industrial
 (home, irrigation, municipal, industrial)

WELL COMPLETION DATA:

- (1) diameter (inches) 10x8xl
- (2) total depth (feet) 628' 8"
- (3) static water level (feet) 25' ~~285' 5"~~ above top of ground.
- (4) casing Steel, 554' 5"
 (material) (depth)
10x8 if telescope see back.
 (size)
- (5) screen 50', 617' 5"
 (length) (depth to top)
1/2", S.S. S.W.
 (size) (material)
- (6) pump 10 150
 (HP) (yield gpm)
electric
 (type power)
- (7) electric log no
 (yes or no)

 (organization running log)
- (8) how well bottom plugged shot

DRILLERS REMARKS:

If well telescopes please sketch and show depths.

GROUND LEVEL

X			

SECTION 30

Please indicate well location X.

ADDITIONAL INFORMATION

If more than one screen, show locations of each on sketch.