

Sun Flower
B 43
10-67

MISSISSIPPI
BOARD OF WATER COMMISSIONERS
416 North State Street
Jackson, Mississippi 39201

WATER WELL DRILLERS LOG *Sunflower*

10-27-67 *Field County, Farmers Loan* *Field County*
date well completed firm name county well located

LANDOWNER: *H D Legg*
Rt 1 Box 246
Drew Miss
(mailing address)

description of formations encountered	from	to
<i>TOP SOIL, FINE SAND</i>		<i>14</i>
<i>fine sand</i>		<i>14 1/2</i>
<i>med sand 6 1/2'</i>		<i>20 1/2</i>
<i>Coarse sand & gravel</i>		<i>126</i>


WELL LOCATION:
sec *26 T 24 N* R *3 E*
2 miles *East* of *Parchman*
(distance) (direction) (nearest town)

WELL PURPOSE: *Irrigation*
(home, irrigation, municipal, industrial)

WELL COMPLETION DATA:

- (1) diameter (inches) *6*
- (2) total depth (feet) *126*
- (3) static water level (feet) *16* ^{*10*} below / ^{*10*} above top of ground.
- (4) casing *Pipe*, *78*
(material), (depth)
6 if telescope see back.
(size)
- (5) screen *48*, *78*
(length), (depth to top)
6, *Down*
(size), (material)
- (6) pump *30*, *1000*
(HP), (yield gpm)
Tracher
(type power)
- (7) electric log _____
(yes or no)


(organization running log)
- (8) how well bottom plugged *Welded*

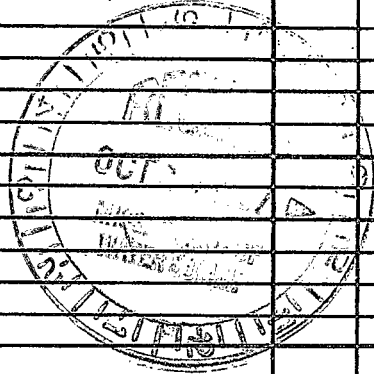

DRILLERS REMARKS:

If well telescopes please sketch and show depths.

GROUND LEVEL

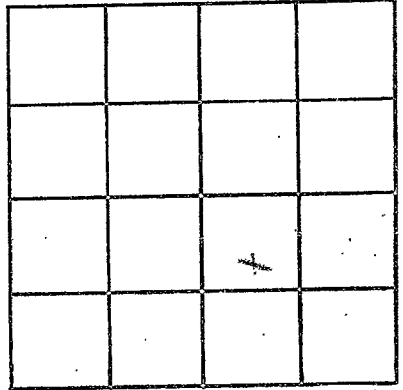

SECTION 26

Please indicate well location X.

ADDITIONAL INFORMATION

If more than one screen, show locations of each on sketch.