

SUNFLOWER

~~D 22844~~

6-20-73

MISSISSIPPI BOARD OF WATER COMMISSIONERS  
416 North State Street  
Jackson, Mississippi 39201

WATER WELL DRILLERS LOG

**CODED**

6/20 date well completed

1973 Dalton Wells & Supplies Co. firm name

San Francisco county well located



LANDOWNER:	description of formations encountered	from	to
Sam Davis	Top soil	0	23
Rt. Tatorville Miss. (mailing address)	Fine sand Black Clay	23	68
WELL LOCATION: sec. 1 <del>23N</del> 24N S R. 3 W	Sand & gravel	68	142
1 1/2 miles (distance) of Rome (direction) of (nearest town)	Blue Clay subsoil	142	220
WELL PURPOSE: Home (home, irrigation, municipal, industrial)	Sand & clay shales	220	380
WELL COMPLETION DATA:	Shale & Clay	380	480
(1) diameter (inches) 4 1/2	<del>Clay</del>	480	481
(2) total depth (feet) 567	<del>Clay</del>		
(3) static water level (feet) 23 below top of ground.	Shale & Clay	481	526
(4) casing gal steel (material) (depth) (size) If telescope see back.	Sand	526	567
(5) screen 20 ft (length) (depth to top) 24 stainless steel (size) (material)			
(6) pump 19 (HP) (yield gpm) gal (type power)			
(7) electric log 2/10 (yes or no)			
(8) how well bottom plugged B.P. Value			
DRILLERS REMARKS:			

JUL 30 1973

If well telescopes please  
sketch and show depths.



GROUND LEVEL

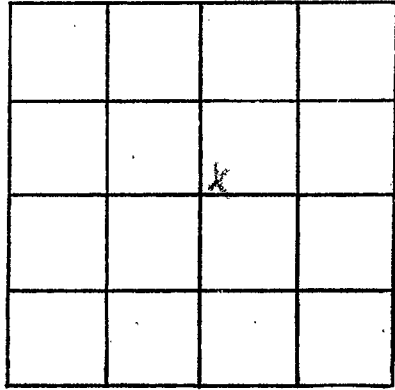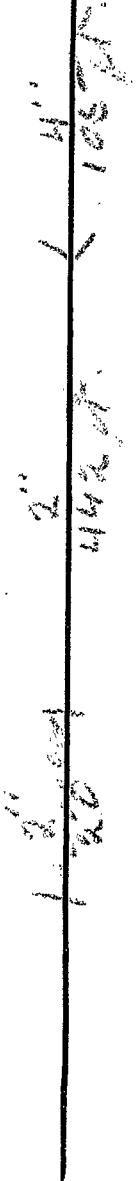

SECTION 1

Please indicate well location X.

**ADDITIONAL INFORMATION**

---

---

If more than one screen,  
show locations of each on sketch.

