

SUNFLOWER  
~~A10 BAS~~  
 4-26-72

MISSISSIPPI  
 BOARD OF WATER COMMISSIONERS  
 416 North State Street  
 Jackson, Mississippi 39201

WATER WELL DRILLERS LOG

C14578-3793

April 26, 1972 SINGER-Layne Central Division Sunflower  
 date well completed firm name county well located

LANDOWNER: Miss. State Pen  Parchman, Mississippi  (mailing address)	description of formations encountered	from	to
	Clay	0	19

WELL LOCATION:  
 sec. 31 T 24 N R 3 W  
 (distance) miles (direction) of Parchman (nearest town)

Fine sand	19	48
Coarse sand	48	69
Coarse sand & pea gravel	69	98
Coarse sand & gravel	98	119
Coarse sand & big gravel	119	121

WELL PURPOSE: irrigation  
 (home, irrigation, municipal, industrial)

- WELL COMPLETION DATA:
- (1) diameter (inches) 16
  - (2) total depth (feet) 121
  - (3) static water level (feet) 24' below top of ground.
  - (4) casing steel 71' (material), (depth)  
 16" (size) If telescope see back.
  - (5) screen ~~ARMCO~~ 50' 121' (length), (depth to top)  
 16" (size) Armco (material)
  - (6) pump 30 1800 (HP) (yield gpm)  
 engine (type/power)
  - (7) electric log no (yes or no)  
 (organization running log)
  - (8) how well bottom plugged plate

100HP Diesel  
 2500 gpm (pumping test)  
 From: John McVey  
 10/22/76  
 JMB

**CODED**


MAY 10 1972

MISS. B. OF WATER

DRILLERS REMARKS:

If well telescopes please sketch and show depths.

GROUND LEVEL

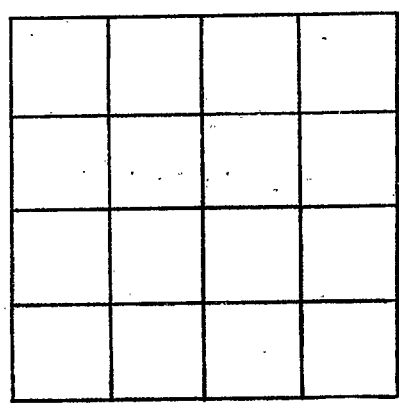

SECTION \_\_\_\_\_

Please indicate well location X.

ADDITIONAL INFORMATION

If more than one screen, show locations of each on sketch.