

Sunflower  
 B 46  
 6-3-75

MISSISSIPPI  
 BOARD OF WATER COMMISSIONERS  
 416 North State Street  
 Jackson, Mississippi 39201

CODED

WATER WELL DRILLERS LOG

Senger-Rayne  
 Williams Farms

June 3, 19 75  
 date well completed

firm name

Sunflower  
 county well located

| LANDOWNER: Williams Farms<br>Box 388<br>Tutwiler, Miss.<br>(mailing address)                                       | description of formations encountered | from | to   |
|--|---------------------------------------|------|------|
|  | Clay                                  | 0    | 38'  |
|  | Coarse sand & Gravel                  | 38   | 104' |
| WELL LOCATION:<br>sec. 12 T 24 N R 3 E 15H<br>S W<br>1 miles East of Rome<br>(distance) (direction) (nearest town) |                                       |      |      |
| WELL PURPOSE: irrigation<br>(home, irrigation, municipal, industrial)  |                                       |      |      |
| WELL COMPLETION DATA:  |                                       |      |      |
| (1) diameter (inches) 12"  |                                       |      |      |
| (2) total depth (feet) 104'  |                                       |      |      |
| (3) static water level (feet) 18 below above-top of ground.  |                                       |      |      |
| (4) casing Steel 44'<br>(material) (depth)<br>12" If telescope see back.<br>(size)                                 |                                       |      |      |
| (5) screen 60' 60'<br>(length) (depth to top)<br>16" Steel<br>(size) (material)                                    |                                       |      |      |
| (6) pump 60 2800<br>(HP) (yield gpm)<br>engine<br>(type power)   |                                       |      |      |
| (7) electric log no<br>(yes or no)<br><br>(organization running log)   |                                       |      |      |
| (8) how well bottom plugged steel plate  |                                       |      |      |
| DRILLERS REMARKS:  |                                       |      |      |


CODED

RECEIVED  
 JUN 14 1975

MISS. BD. OF WATER COMMISSIONERS

If well telescopes please sketch and show depths.

GROUND LEVEL

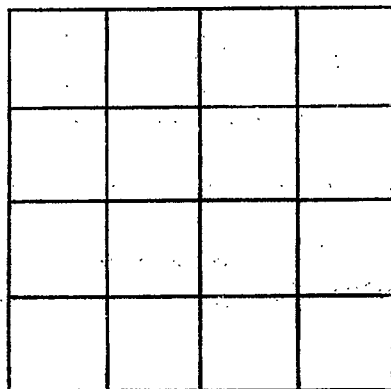

SECTION \_\_\_\_\_

Please indicate well location X.

ADDITIONAL INFORMATION

If more than one screen, show locations of each on sketch.