

CODED

MISSISSIPPI
BOARD OF WATER COMMISSIONERS
416 North State Street
Jackson, Mississippi 39201

WATER WELL DRILLERS LOG

SUNFLOWER
B 47
1-9-75

January 9, 1975 Dyer-Sullivan, Inc. Sunflower
date well completed firm name county well located

LANDOWNER: Agnew Safety
P.O. Box 128
Rome, Miss.
(mailing address)

description of formations encountered	from	to
	Clay	0
Fine Sand	31	72
Sand & Gravel	72	112

WELL LOCATION:
sec. 4 T. 24 N. R. 3 E. 15H
2 miles NW of ROME
(distance) (direction) (nearest town)

WELL PURPOSE: irrigation
(home, irrigation, municipal, industrial)

WELL COMPLETION DATA:

- (1) diameter (inches) 16"
- (2) total depth (feet) 112
- (3) static water level (feet) 14 below above top of ground.
- (4) casing Blk. Iron, 76'
(material) (depth)
16" If telescope see back.
(size)
- (5) screen 40', 76'
(length) (depth to top)
16", Blk. Ingot
(size) (material)
- (6) pump 600 300
(HP) (yield gpm)
Dieso 3000
(type power)
- (7) electric log No
(yes or no)
- (organization running log)
- (8) how well bottom plugged Plate


MISSISSIPPI BOARD OF WATER COMMISSIONERS
JAN 12 1975

DRILLERS REMARKS:

MISS. BD. OF WATER COMMISSIONERS

If well telescopes please sketch and show depths.

GROUND LEVEL

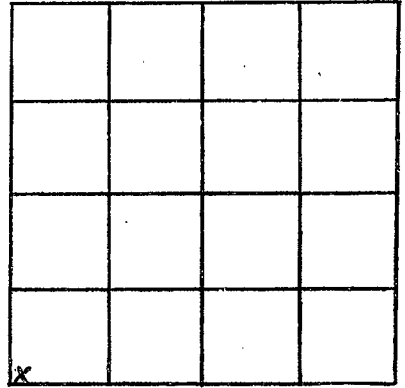

SECTION 4

Please indicate well location X.

ADDITIONAL INFORMATION

If more than one screen,
show locations of each on sketch.