

SUNFLOWER

B-55

6-19-80

6-19

date well completed

1980

MISSISSIPPI BOARD OF WATER COMMISSIONERS 416 North State Street Jackson, Mississippi 39201

CODED

WATER WELL DRILLERS LOG

Fine Co. Farm, Osprey

firm name

Sunflower

county well located

LANDOWNER: W.D. Patterson

Rome Miss.

(mailing address)

WELL LOCATION:

sec. 15 T. 24 N. S. R. 5 E. W. 7 miles South of Rome (distance) (direction) (nearest town)

WELL PURPOSE: (home, irrigation, municipal, industrial)

WELL COMPLETION DATA:

- (1) diameter (inches) 12"
(2) total depth (feet) 110'
(3) static water level (feet) 23 below above top of ground.
(4) casing Steel, 60' (material) (depth) 12" (size) if telescope see back.
(5) screen 50' 60' (length) (depth to top) 12" Steel (size) (material)
(6) pump 60 800 (HP) (yield gpm) diard (type power)
(7) electric log no (yes or no)
(organization running log)
(8) how well bottom plugged sealed

description of formations encountered

from

to

Table with 3 columns: description of formations encountered, from, to. Rows include Top Clay, Fine sand, Clay, Coarse sand, Red sand & gravel, Sand & gravel.

CODED

DEPT. OF NATURAL RESOURCES BUREAU OF LAND & WATER RESOURCES


JUL 25 1980

RECEIVED

DRILLERS REMARKS:

If well telescopes please sketch and show depths.

GROUND LEVEL

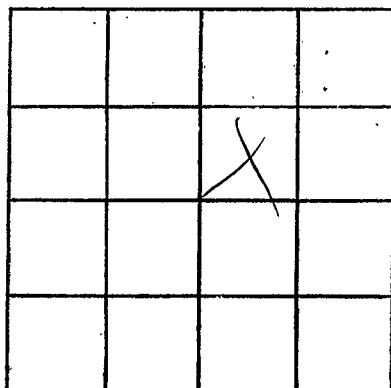

SECTION 15

Please indicate well location X.

ADDITIONAL INFORMATION

If more than one screen,
show locations of each on sketch.