

Sunflower
B59
3-18-80

MISSISSIPPI
 BOARD OF WATER COMMISSIONERS
 416 North State Street
 Jackson, Mississippi 39201

CODED

WATER WELL DRILLERS LOG

3/18 1980 Dyer Sunflower
 date/well completed first name county well located

LANDOWNER:
RED AUSTIN
PARCHMAN
 (mailing address)

WELL LOCATION:
 sec. 36 T 24 N R 3 E
3 miles S of Parchman
 (distance) (direction) (nearest town)

description of formations encountered	from	to
<u>Clay</u>	<u>0</u>	<u>28</u>
<u>Fine Sand</u>	<u>28</u>	<u>38</u>
<u>Sand</u>	<u>38</u>	<u>48</u>
<u>Sand & Gravel</u>	<u>48</u>	<u>103</u>

WELL PURPOSE: Domestic
 (home, irrigation, municipal, industrial)

WELL COMPLETION DATA:

(1) diameter (inches) 12"

(2) total depth (feet) 103'

(3) static water level (feet) 19' below above top of ground.

(4) casing Steel 103'
 (material) (depth)
12" if telescope see back.
 (size)

(5) screen 40' 63'
 (length) (depth to top)
12" Steel
 (size) (material)


(6) pump 40 2000
 (HP) (yield gpm)
electric
 (type power)

(7) electric log _____
 (yes or no)

 (organization running log)

(8) how well bottom plugged plate


CODED

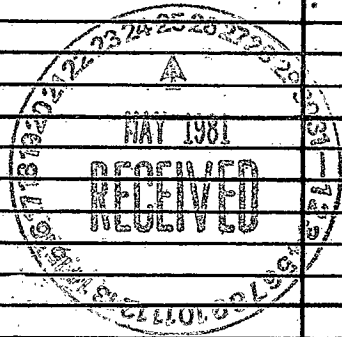

DRILLERS REMARKS:

If well telescopes please sketch and show depths.

GROUND LEVEL

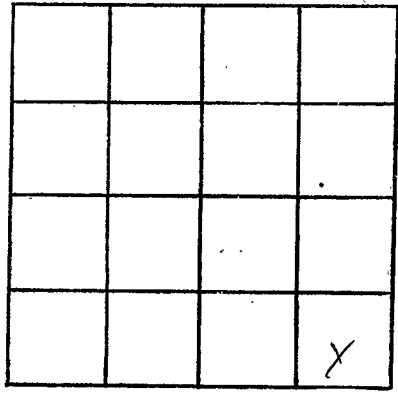

SECTION 36

Please indicate well location X.

ADDITIONAL INFORMATION

A series of horizontal lines for writing additional information, starting below the 'ADDITIONAL INFORMATION' header and extending to the bottom of the page.

If more than one screen, show locations of each on sketch.