

Sunflower
B60
11-29-79

MISSISSIPPI
BOARD OF WATER COMMISSIONERS
416 North State Street
Jackson, Mississippi 39201

CODED

WATER WELL DRILLERS LOG

11/29 1979 date well completed
Dyer firm name
Sunflower county well located

LANDOWNER:
BOB ED WRIGHT
ROME, MS.
(mailing address)


description of formations encountered	from	to
Clay	0	23
Fine Sand	23	35
Sand	35	45
Sand & Gravel	45	104

WELL LOCATION:
sec. 25 T 24 N R 3 E
4 miles S E of Rome
(distance) (direction) (nearest town)

WELL PURPOSE: Irrigation
(home, irrigation, municipal, industrial)

- WELL COMPLETION DATA:
- (1) diameter (inches) 16"
 - (2) total depth (feet) 104'
 - (3) static water level (feet) 20' below top of ground.
 - (4) casing Steel (material), 104' (depth)
16" (size) if telescope see back.
 - (5) screen 40' (length), 64' (depth to top)
16" (size), Steel (material)
 - (6) pump 60 (HP), 3000 (yield gpm)
Propane (type power)
 - (7) electric log (yes or no)
 - (organization running log)
 - (8) how well bottom plugged photo


CODED

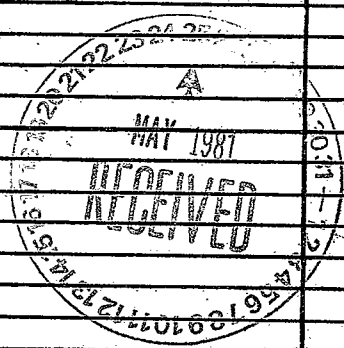

DRILLERS REMARKS:

If well telescopes please sketch and show depths.

GROUND LEVEL

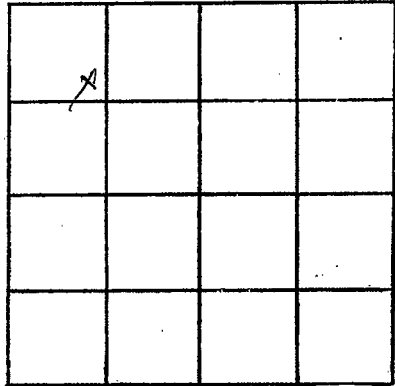

SECTION 25

Please indicate well location X.

ADDITIONAL INFORMATION

Lined area for additional information.

If more than one screen, show locations of each on sketch.