

Sunflower
B 61
4-17-81

MISSISSIPPI
BOARD OF WATER COMMISSIONERS
416 North State Street
Jackson, Mississippi 39201

CODED

WATER WELL DRILLERS LOG

4-17 1981 Five Co. Form Sunflower
date well completed firm name county well located

LANDOWNER: W. D. Patterson
Home Man

description of formations encountered	from	to
<u>Top Clay</u>	<u>0</u>	<u>6</u>
<u>Fine Sand</u>	<u>6</u>	<u>24</u>
<u>Med Sand</u>	<u>24</u>	<u>46</u>
<u>Coarse Sand</u>	<u>46</u>	<u>64</u>
<u>Sand & Gravel</u>	<u>64</u>	<u>104</u>

(mailing address)

WELL LOCATION:
sec 24 T 24 N R 3 E
S
1/2 miles E of Bone
(distance) (direction) (nearest town)

WELL PURPOSE:
(home, irrigation, municipal, industrial)

CODED
DEPT. OF NATURAL RESOURCES
BUREAU OF LAND & WATER RESOURCES

- WELL COMPLETION DATA:
- diameter (inches) 16"
 - total depth (feet) 104
 - static water level (feet) 24 ^{below} above top of ground.
 - casing Steel, 54
(material) (depth)
16 If telescope see back.
(size)
 - screen 50, 54'
(length) (depth to top)
16", Steel-Bronze
(size) (material)
 - pump 60, 3000
(HP) (yield gpm)
Elec
(type power)
 - electric log no
(yes or no)
- (organization running log)
- (8) how well bottom plugged yes


AUG 26 1981

RECEIVED

DRILLERS REMARKS:

If well telescopes please
sketch and show depths.

GROUND LEVEL

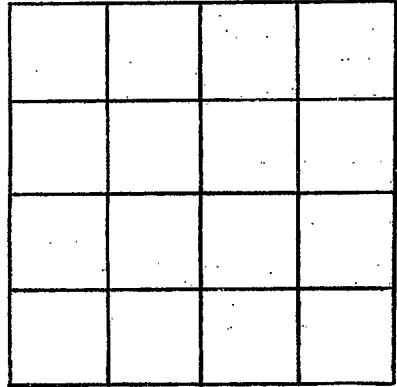

SECTION _____

Please indicate well location X.

ADDITIONAL INFORMATION

If more than one screen,
show locations of each on sketch.