

Sunflower  
B 62  
4-16-81

MISSISSIPPI  
 BOARD OF WATER COMMISSIONERS  
 416 North State Street  
 Jackson, Mississippi 39201

WATER WELL DRILLERS LOG

**CODED**

4-16 1981 Sunflower Sunflower  
 date well completed firm name county well located

LANDOWNER: W.D. Patterson  
Home

description of formations encountered	from	to
<u>Top Clay</u>	<u>0</u>	<u>7</u>
<u>Thin Sand</u>	<u>7</u>	<u>18</u>
<u>Med Sand</u>	<u>18</u>	<u>39</u>
<u>Coars Sand</u>	<u>39</u>	<u>64</u>
<u>Sand &amp; gss</u>	<u>64</u>	<u>107</u>

(mailing address)  
 WELL LOCATION:  
 sec. 22 T 24(N) S R 3 E  
3/4 miles N-E of Brookline  
 (distance) (direction) (nearest town)

WELL PURPOSE:  
 (home, irrigation, municipal, industrial)

WELL COMPLETION DATA:  
 (1) diameter (inches) 16"  
 (2) total depth (feet) 107  
 (3) static water level (feet) 236 below top of ground.  
 (4) casing Steel, 57 (material), (depth)  
16" (size) if telescope see back.  
 (5) screen 50 (length), 57 (depth to top)  
16" (size), Steel-Brows (material)  
 (6) pump 40 (HP), 2300 (yield gpm)  
Elec (type power)  
 (7) electric log no (yes or no)  
 (organization running log)  
 (8) how well bottom plugged well

**CODED**  
 DEPT. OF NATURAL RESOURCES  
 BUREAU OF LAND & WATER RESOURCES

AUG 26 1981


**RECEIVED**

AUG 1981  
**RECEIVED**

DRILLERS REMARKS:

If well telescopes please sketch and show depths.

GROUND LEVEL

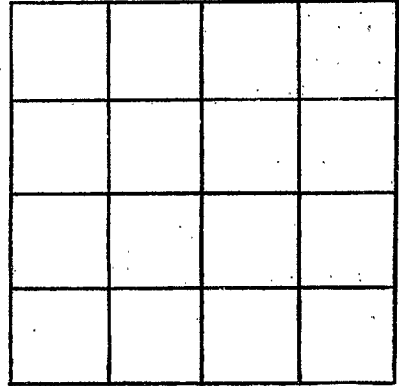

SECTION \_\_\_\_\_

Please indicate well location X.

ADDITIONAL INFORMATION

If more than one screen, show locations of each on sketch.