

Sunflower  
B 63  
4-15-81

MISSISSIPPI  
 BOARD OF WATER COMMISSIONERS  
 416 North State Street  
 Jackson, Mississippi 39201

**CODED**

WATER WELL DRILLERS LOG

4-15 1981 Fire Co Farmer Sunflower  
 date well completed firm name county well located

LANDOWNER: W.D. Patterson  
Home mine

description of formations encountered	from	to
<u>top clay</u>	<u>0</u>	<u>6</u>
<u>Fluvial sand</u>	<u>6</u>	<u>30</u>
<u>med sand</u>	<u>30</u>	<u>45</u>
<u>Coarse sand</u>	<u>45</u>	<u>66</u>
<u>sand &amp; gra</u>	<u>66</u>	<u>100</u>

(mailing address)

WELL LOCATION:  
 sec 21 T 24 N R 3 E  
S  
1 1/4 miles NE of Bordman  
 (distance) (direction) (nearest town)

WELL PURPOSE:  
 (home, irrigation, municipal, industrial)

WELL COMPLETION DATA:

- (1) diameter (inches) 16"
- (2) total depth (feet) 100
- (3) static water level (feet) 22 below top of ground. above
- (4) casing Steel, 50 (material), (depth)  
16 (size) if telescope see back.
- (5) screen 50, 50 (length), (depth to top)  
16, Steel-Brown (size), (material)
- (6) pump 60 (HP), 2260 (yield gpm)  
direct (type power)
- (7) electric log no (yes or no)  
 (organization running log)
- (8) how well bottom plugged sealed

DRILLERS REMARKS:

DEPT. OF NATURAL RESOURCES  
 BUREAU OF LAND & WATER RESOURCES


AUG 26 1981

RECEIVED

254272R 2950  
 AUG 1981  
 RECEIVED  
 123456789101112131415161718192021222324

If well telescopes please sketch and show depths.

GROUND LEVEL

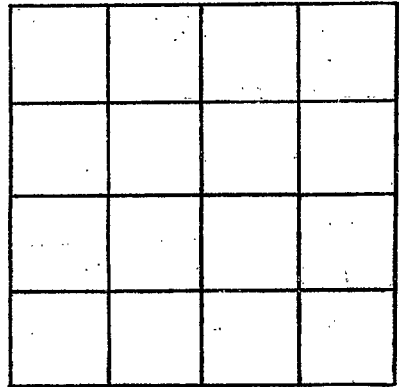

SECTION \_\_\_\_\_

Please indicate well location X.

ADDITIONAL INFORMATION

If more than one screen, show locations of each on sketch.