

MISSISSIPPI DEPARTMENT OF NATURAL RESOURCES

Bureau of Land and Water Resources

Southport Mall

P.O. Box 10631

Jackson, Mississippi 39209

WATER WELL DRILLERS LOG

CODED

SUNFLOWER
B. 66
MAY 1981

MAY 19 81 date well completed
LEEPER Drilling firm name
Sunflower county well located

LANDOWNER: #1
Tom Davis
Rome Ms. (mailing address)

WELL LOCATION:
sec. 13 T24 N R 3 E
3 miles E of Rome
(distance) (direction) (nearest town)

WELL PURPOSE: irrigation
(home, irrigation, municipal, industrial)

WELL COMPLETION DATA:

(1) diameter (inches) 12

(2) total depth (feet) 122

(3) static water level (feet) 16 below top of ground

(4) casing Steel, 82 (material), (depth)

(5) screen 40, 82 (length), (depth to top)

12, Steel (size), (material)

(6) pump 50, 2000 (HP), (yield gpm)

Electric (type power)

(7) electric log NO (yes or no)

(organization running log)


(8) how well bottom plugged CAP

description of formations encountered	from	to
top clay	0	25
fine sand	25	45
COARSE SAND and gravel	45	122

DRILLERS REMARKS:

If well telescopes please
sketch and show depths.

GROUND LEVEL

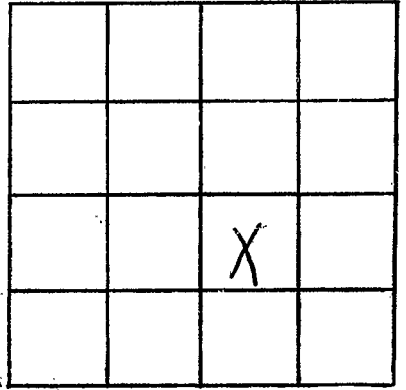


SECTION 13

Please indicate well location X.

ADDITIONAL INFORMATION

Multiple horizontal lines for additional information.

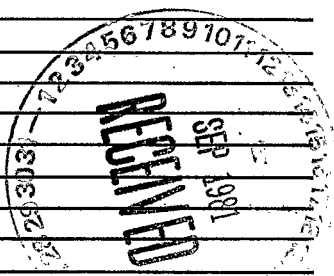

If more than one screen,
show locations of each on sketch.