

MISSISSIPPI DEPARTMENT OF NATURAL RESOURCES
Bureau of Land and Water Resources
 Southport Mall
 P.O. Box 10631
 Jackson, Mississippi 39209
WATER WELL DRILLERS LOG

10
CODED

B70
 EL-2551 **SUNFLOWER**
 9-28-83

9-28 1983 LAYNE-CENTRAL CO. SUNFLOWER
 date well completed firm name county well located


LANDOWNER:	description of formations encountered	from	to
MS STATE BUILDING COMMISSION MS STATE PENITENTIARY			
PARCHMAN, MS (mailing address)	sand	26	85
	coarse sand	85	110
WELL LOCATION: sec. 29 T. 24 N R. 3 W Parchman (distance) miles (direction) of (nearest town)	coarse sand/pea gravel	110	160
	rock	160	161
WELL PURPOSE: municipal (home, irrigation, municipal, industrial)	sand	161	185
	clay	185	192
WELL COMPLETION DATA: (1) diameter (inches) 15"	sand	192	330
	stk. of clay w/sand	330	367
(2) total depth (feet) 27' 8"	fine sand/clay	367	448
(3) static water level (feet) 27' 8" below top of ground.	rock	448	449
(4) casing steel 1193' (material) (depth) 10" (size) if telescope see back.	fine sand	449	470
(5) screen 61' 1195' (length) (depth to top) 6" st. steel (size) (material)	clay	470	541
(6) pump 30 350 (HP) (yield gpm) electric (type power)	clay	623	697
(7) electric log Yes (yes or no) MSGS (organization running log)	sandy shale	697	750
(8) how well bottom plugged 6" BP valve	stk. of sand/shale	750	768
DRILLERS REMARKS:	rock	768	769
	stk. of sand/shale	769	790
	stk. of rock/sand	790	821
	fine green sand		
	clay	863	877
	sandy shale	877	927
	stk. of sand/shale	927	1091
	clay	1091	1153
	stk. of sand/shale	1153	1168
	fine sand/stk. of shale	1168	1228
	fine sand	1228	1255
	clay	1255	1265

CODED

DEPT. OF NATURAL RESOURCES
 BUREAU OF LAND & WATER RESOURCES
 MAY 25 1984
RECEIVED

If well telescopes please sketch and show depths.

GROUND LEVEL

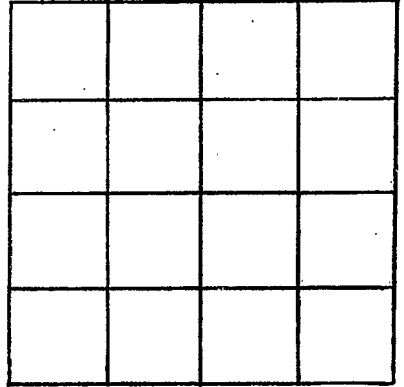

SECTION _____

Please indicate well location X.

ADDITIONAL INFORMATION

If more than one screen,
show locations of each on sketch.