

MISSISSIPPI DEPARTMENT OF NATURAL RESOURCES

Bureau of Land and Water Resources

Southport Mall

P.O. Box 10631

Jackson, Mississippi 39209

WATER WELL DRILLERS LOG

B72  
Sunflower  
3-3-84

CODED

3/3/84 19 Powell Irrigation Sunflower  
date well completed firm name county well located

LANDOWNER:	description of formations encountered	from	to
<u>Agnew Salyer</u> <u>Rome, MS</u> (mailing address)			
	<u>Fine Sand (Hard Packed)</u>	<u>13</u>	<u>60</u>
	<u>COARSE SAND</u>	<u>60</u>	<u>70</u>
	<u>COARSE SAND &amp; GRAVEL</u>	<u>70</u>	<u>110</u>
WELL LOCATION:			
sec. <u>4</u> T. <u>24</u> (N) S R. <u>3</u> E (W)			
<u>2</u> miles <u>NW</u> of <u>Rome</u> (distance) (direction) (nearest town)			
WELL PURPOSE: <u>Location</u> (home, irrigation, municipal, industrial)			
WELL COMPLETION DATA:			
(1) diameter (inches) <u>16"</u>			
(2) total depth (feet) <u>110'</u>			
(3) static water level (feet) <u>35'</u> below above top of ground.			
(4) casing <u>Steel</u> , <u>70'</u> (material) (depth) (size) if telescope see back.			
(5) screen <u>40'</u> , <u>70'</u> (length) (depth to top) <u>16"</u> , <u>Steel</u> (size) (material)			
(6) pump <u>60</u> <u>3000</u> (HP) (yield gpm) <u>Diesel</u> (type power)			
(7) electric log <u>no</u> (yes or no) (organization running log)			
(8) how well bottom plugged <u>Steel Plate</u>			

DEPT. OF NATURAL RESOURCES  
BUREAU OF LAND & WATER RESOURCES


MAR 29 1984

RECEIVED

DRILLERS REMARKS:

If well telescopes please sketch and show depths.

GROUND LEVEL

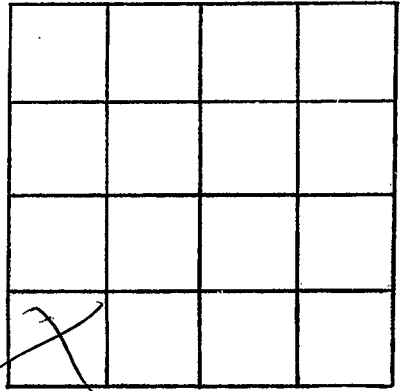

SECTION 4

Please indicate well location X.

ADDITIONAL INFORMATION

If more than one screen,  
show locations of each on sketch.