

MISSISSIPPI DEPARTMENT OF NATURAL RESOURCES

Bureau of Land and Water Resources

Southport Mall

P.O. Box 10631

Jackson, Mississippi 39209

CODED

WATER WELL DRILLERS LOG

B73
Sunflower
7-15-84

7/84 19
date well completed

Powell IRRIGATION Sunflower
firm name county well located

LANDOWNER:
T. C. Bussard
(mailing address)

description of formations encountered	from	to
CLAY	0	20
CLAY + SAND	20	40
Med & Coarse Sand	40	60
Coarse Sand + Gravel	60	100

WELL LOCATION:
sec. 35 T 24 N R. 3 E
S W
2 miles SE of Pochman
(distance) (direction) (nearest town)

WELL PURPOSE: IRRIGATION
(home, irrigation, municipal, industrial)

WELL COMPLETION DATA:

(1) diameter (inches) 12

(2) total depth (feet) 100

(3) static water level (feet) 25 below above top of ground.

(4) casing Steel, 60
(material) (depth)
(size) If telescope see back.

(5) screen 40, 60
(length) (depth to top)
12, Steel
(size) (material)

(6) pump 80, 1500
(HP) (yield gpm)
Diesel
(type power)

(7) electric log NO
(yes or no)

(organization running log)

(8) how well bottom plugged
Steel + Gravel

DRILLERS REMARKS:


DEPT. OF NATURAL RESOURCES
BUREAU OF LAND & WATER RESOURCES

NOV 29 1984

RECEIVED

If well telescopes please sketch and show depths.

GROUND LEVEL

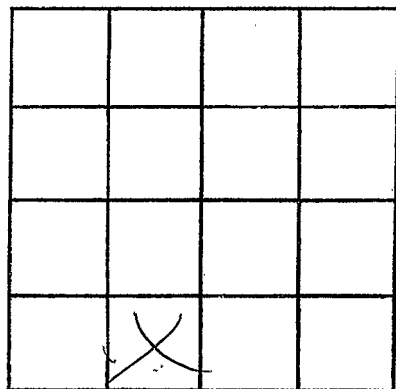

SECTION 35

Please indicate well location X.

ADDITIONAL INFORMATION

If more than one screen,
show locations of each on sketch.