

MISSISSIPPI DEPARTMENT OF NATURAL RESOURCES

Bureau of Land and Water Resources

Southport Mall

P.O. Box 10631

CODED

Jackson, Mississippi 39209

WATER WELL DRILLERS LOG

B74
Sunflower
7-15-84

Sunflower

7/84 19 Powell IRRIGATION date well completed
firm name
county well located

LANDOWNER:
T. C. RUSFORD
(mailing address)

description of formations encountered	from	to
CLAY	0	20
CLAY + SAND	20	40
Med SAND	40	60
COARSE SAND/CLAY	60	100

WELL LOCATION:
sec. 35 24 N R 3 E
1 miles SE of PARCHMAN
(distance) (direction) (nearest town)

WELL PURPOSE: IRRIGATION
(home, irrigation, municipal, industrial)

WELL COMPLETION DATA:

(1) diameter (inches) 12

(2) total depth (feet) 100

(3) static water level (feet) 25 below above top of ground.

(4) casing Steel, 60 (material) (depth)
(size) if telescope see back.

(5) screen 40, 60 (length) (depth to top)
12, Steel (size) (material)

(6) pump 80, 1500 (HP) (yield gpm)
Diesel (type power)

(7) electric log NO (yes or no)
(organization running log)

(8) how well bottom plugged: Steel Plate

DEPT. OF NATURAL RESOURCES
BUREAU OF LAND & WATER RESOURCES


NOV 29 1984

RECEIVED

DRILLERS REMARKS:

If well telescopes please sketch and show depths.

GROUND LEVEL

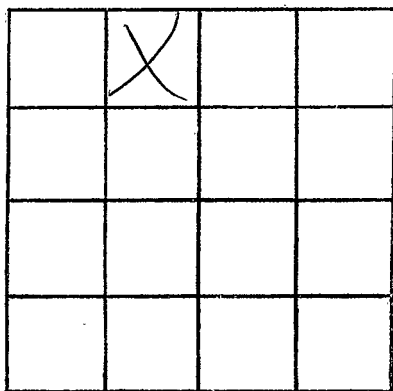

SECTION 35

Please indicate well location X.

ADDITIONAL INFORMATION

If more than one screen,
show locations of each on sketch.