

MISSISSIPPI DEPARTMENT OF NATURAL RESOURCES

Bureau of Land and Water Resources

Southport Mall

P.O. Box 10631

Jackson, Mississippi 39209

WATER WELL DRILLERS LOG

CODED

SUNFLOWER	
B	75

date well completed

firm name

county well located

7/86, 19 Powell Dr Sunflower

LANDOWNER:	description of formations encountered	from	to
Agnew Saffley	Clay	0	33
Rome, MS	Fine sand	33	73
(mailing address)	Coarse sand	73	123
	Gravel		

WELL LOCATION:

sec. 5 T 24 N R 3 E

5 miles NW of Rome

(distance) (direction) (nearest town)

WELL PURPOSE: Drill

(home, irrigation, municipal, industrial)

WELL COMPLETION DATA:

(1) diameter (inches) 16

(2) total depth (feet) 123

(3) static water level (feet) 29 below above top of ground.

(4) casing steel 83

(material) (depth)

(size) if telescope see back.

(5) screen 40 83

(length) (depth to top)

16 steel

(size) (material)

(6) pump 60 2200

(HP) (yield gpm)

diesel

(type power)

(7) electric log NO

(yes or no)

(organization running log)

(8) how well bottom plugged steel plate

CODED

RECEIVED


OCT 27 1986

Department of Natural Resources  
Bureau of Land & Water Resources

DRILLERS REMARKS:  
86204 MGS - 01

If well telescopes please sketch and show depths.

GROUND LEVEL

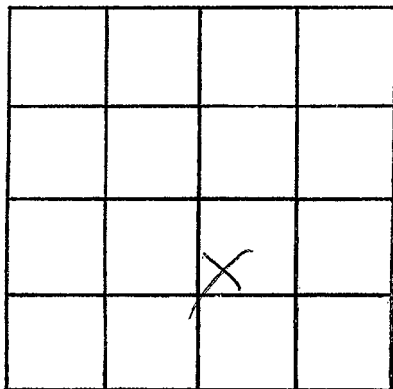

SECTION 5

Please indicate well location X.

ADDITIONAL INFORMATION

If more than one screen,  
show locations of each on sketch.