

MISSISSIPPI DEPARTMENT OF NATURAL RESOURCES

Bureau of Land and Water Resources

Southport Mall

P.O. Box 10631

Jackson, Mississippi 39209

WATER WELL DRILLERS LOG

Sunflower
B 84

107B-0108A

CODED
4

4-20-90
 date well completed

90 Stovinity
FE Mitchell #1
 firm name

Sunflower
 county/well located


LANDOWNER: FE Mitchell
Po Box 117
Rome Ms 38768
 (mailing address)

WELL LOCATION:
 sec. 3 T 24 N R 3 E
3 miles Northwest of Rome
 (distance) (direction) (nearest town)

description of formations encountered	depth	
	from	to
<u>Top soil</u>	<u>0</u>	<u>3</u>
<u>clay</u>	<u>3</u>	<u>30</u>
<u>Corke Don</u>	<u>30</u>	<u>50</u>
<u>pea gravel</u>	<u>50</u>	<u>75</u>
<u>Roche</u>	<u>75</u>	<u>108</u>

WELL PURPOSE: Dr
 (home, irrigation, municipal, industrial)

- WELL COMPLETION DATA:
- (1) diameter (inches) 16"
 - (2) total depth (feet) 108"
 - (3) static water level (feet) 21' below top of ground.
 - (4) casing steel, 68" (material), (depth)
 - (size) if telescope see back.
 - (5) screen 40', 68" (length), (depth to top)
 - (size), (material)
 - (6) pump _____ (HP) _____ (yield gpm)
 - (type power)
 - (7) electric log _____ (yes or no)
 - (organization running log)
 - (8) how well bottom plugged steel plate

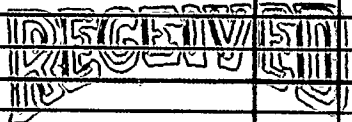


MAY 20 1992

Dept. of Environmental Quality
 Bureau of Land & Water Resources

DRILLERS REMARKS:

If well telescopes please sketch and show depths.

GROUND LEVEL

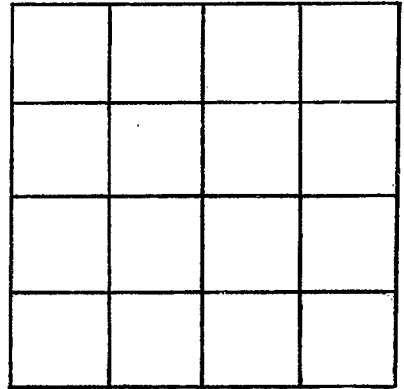

SECTION _____

Please indicate well location X.

ADDITIONAL INFORMATION

If more than one screen,
show locations of each on sketch.