State V	Well Report For Office Use Only:	
County: Sunflower	Part 1	
Mississippi Departme	Mississippi Department of Environmental Quality Aquifer:	
Try detion Tour manual	Office of Land and Water Resources Well #: $B - 10.3$	
Driller:	. Box 10631	
6-17-06	MS 39289-0631	
	19501-5210 154-6938 (fax) E-log #:	
(001)3	2 kg	
State Law requires that this report be prepared by the driller in detail and filed with the Department within 30 days of completion of drilling of the well.		
Well Owner Information	Well Location	
Owner Name Haney Farms	Latituda, 33 058 44 17 Langituda; 90 0 30 , 49 20	
Owner Name Harrey Farms	Latitude: 33 •58 44 • 1" Longitude: 90 • 30 · 49 • 0 49 Method of Lat/Long (circle one): Conventional Survey,	
Mailing Address: Box 206	Method of Lat/Long (circle one): Conventional Survey,	
	USGS quad/Hand-held GPS, Survey-grade GPS	
Clambadala NG 20014	SE, DW, Sec 4 Twn 24N Rng 3W	
Clarksdale MS 38614		
City State Zip Code	Distance Direction Nearest Town	
Telephone No. (_3Miles_NWof_Rome	
· · · · · · · · · · · · · · · · · · ·	İ	
· Wel	l Data	
Purpose of Well (circle one) Home Industrial Public Supply	Fish Culture Others	
Date well drilling started: $6-17-06$ Date well drilling completed: $6-17-06$		
Ifficuity method officer months on Wales	/1	
If flowing, method of flow regulation: Valve Other		
Static Water Level: 40' feet above on below (circle one) land surface Date measured: $6-20-06$	
	ne air line other:	
Hole depth: 125 Well depth: 125	Well grouted to a depth of 10 feet	
Type of grout (circle one): Cement Bentonite Min	ĸ	
Casing length: 85 feet Casing diameter: 16 inches Type of casing: PVC Sch, 40		
Screen length: 40 feet Screen diameter: 16	inches Type of screen: PVC Sch. 40	
Screen slot size: inches Setting depth: From	86 feet to 125 feet	
Type of completion (circle all applicable): Gavel packed Underreamed Telescoped Open hole Natural Development		
Other (describe):		
Top of lap pipe or reduction in casing: feet. If telescoped or more than one screen, describe on back of page		
Logs run (circle all applicable): No log run Electric Gamma Ray Density Sonic Neutron Other:		
Logs run (circle an applicable). No log run Electric Gamma Ra	y Density Sonic Neutron Other:	
Name of organization running log(s):	•	

I certify that the well was drilled, constructed, and completed in accordance with all applicable requirements of the Mississippi

Department of Environmental Quality and/or the Mississippi Department of Health regulations and state laws.

Irrigation Equipment Inc.

Patrick M. Chism

Print Name of Water Well Contractor and License No.

Signature of Water Well Contracts CEIVED


JUL 1 0 2006

BY OLWE

Ground Level

Description of Formations Encountered	From To
clay	0 35
Fine Sand Fine Sand/gravel Med. Sand/gravel	36 42
Fine Sand/gravel	43 61
Med. Sand/gravel	62 25
	
	
	
	
	
	
	
	
	

If more than one screen, show location of each on sketch

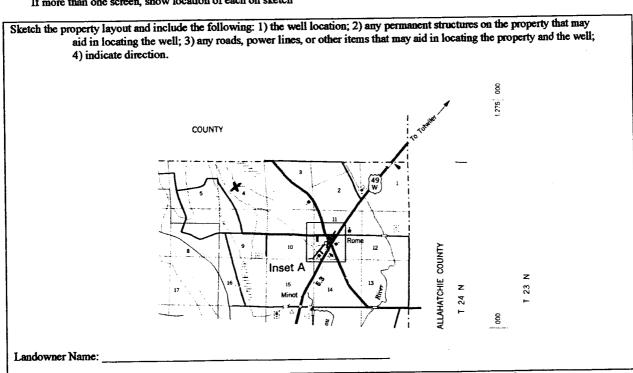

STATE WELL REPORT

Part 2

Sunflower

6-17<u>-06</u>

Permit#: <u>6W 41179</u> Irrigation Equipment Driller:_____

Date completed: _

Pump Installer's Completion Report
Mississippi Department of Environmental Quality
Office of Land and Water Resources
P.O. Box 10631
Jackson, MS 39289-0631
(601)961-5210
(601)354-6938 (fax)

For Office Use Only:	
Aquifer:	<i>*</i>
Well#:	103

Copy information from block on Part 1	(002)557 0550 (mile)	
report must be attached and both parts filed with the Depart	water well contractor or a licensed pump installer. A copy of Part 1 of the partment at the above address within 30 days of well completion.	
Well Owner Information	Well Location	
Owner Name: Haney Farms	1	
Mailing Address: Box 206	Method of Lat/Long (check one): Conventional Survey,	
	USGS quad, Hand-held GPS, Survey-grade GPS	
Clarksdale MS 386	614 SE 1/4 NW 1/4 Sec 4 T 24N R 3W	
City State Zip Cod	Distance Direction Nearest Town	
Telephone No. ()	3 Miles NW of Rome	
Римр Туре	Power Type	
Circle one	Circle one	
Air Lift let Submersible	Diesel Engine Gasoline Engine Natural Gas	
Bucket Piston Furbine	Electric Motor Hand Tractor PTO	
Centrifugal Rotary Flowing Well	ell Windmill Other (specify):	
Other (specify):	Horse Power Rating of Motor: 60	
Date Pump Installed: 6-20-06	Setting Depth: 70 feet	
Rated Pump Capacity: 2500-3000 Gallons Per M	Minute Number of Stages: 1	
Description of the Control of the Co	Method of Measuring Water Level	
Pump Test Data	Circle one	
Date Well Tested:	Air Line Electric Measuring Line Steel Tape	
Static Water Level (A):Feet Below Land S	Surface	
Pumping Water Level (B):Feet Below Land St	Other (specify):	
Drawdown [(B) - (A)]:Feet Below Land S	Surface For flowing well, measured shut in head:feet	
Test Pumping Rate: Gallons Per M	Minute Well yieldedGPM with a drawdown of	
Duration of Pump Test (minimum 4 hours):	hourshours of pumping	
I HEREBY CERTIFY that the above statements are true to the best of my knowledge. Patrick M. Chism 0695 Print Name of Pump Installer and License No. (if applicable) Signature of Pump Installer		

JUL 10 2006 BY: OLWA