

County: Sunflower
 Permit #: CCW 43308
 Irrigation Equipment
 Driller:
 Date drilling completed: 6-30-09

State Well Report

Part 1

Mississippi Department of Environmental Quality
 Office of Land and Water Resources
 P.O. Box 10631
 Jackson, MS 39289-0631
 (601)961-5210
 (601)354-6938 (fax)

For Office Use Only:
 Aquifer: _____
 Well #: B122
 L. S. Elevation: _____
 E-log #: _____

State Law requires that this report be prepared by the driller in detail and filed with the Department within 30 days of completion of drilling of the well.

Well Owner Information	Well Location
Owner Name: <u>Lamar Berryhill</u>	Latitude: <u>33° 56' 59"</u> Longitude: <u>90° 29' 14"</u>
Mailing Address: <u>40 Berryhill Planting Co.</u>	Method of Lat/Long (circle one): <u>Conventional Survey</u>
<u>P.O. Box 100</u>	USGS quad, Hand-held GPS, Survey-grade GPS
<u>Dublin</u> <u>Ms.</u> <u>38739</u>	<u>SE 1/4 NE 1/4 Sec 15</u> Twn <u>24N</u> Rng <u>3W</u>
City State Zip Code	Distance Direction Nearest Town
Telephone No. ()	_____ Miles _____ of <u>Rome</u>

Well Data

Purpose of Well (circle one) Home Industrial Public Supply Irrigation Fish Culture Other: _____

Date well drilling started: 6-30-09 Date well drilling completed: 6-30-09

If flowing, method of flow regulation: Valve _____ Other (describe) _____

Static Water Level: 36 feet above of below (circle one) land surface Date measured: 6-30-09

Method of Measurement (circle one) steel tape electric tape air line other: _____

Hole depth: 127 Well depth: 127 Well grouted to a depth of 10 feet

Type of grout (circle one): Cement Bentonite Mix

Casing length: 87 feet Casing diameter: 10 inches Type of casing: PVC

Screen length: 40 feet Screen diameter: 10 inches Type of screen: PVC

Screen slot size: .050 inches Setting depth: From 88 feet to 127 feet

Type of completion (circle all applicable): Gravel packed Underreamed Telescoped Open hole Natural Development
 Other (describe): _____

Top of lap pipe or reduction in casing: _____ feet. If telescoped or more than one screen, describe on back of page

Logs run (circle all applicable) No log run Electric Gamma Ray Density Sonic Neutron Other: _____

Name of organization running log(s): _____

I certify that the well was drilled, constructed, and completed in accordance with all applicable requirements of the Mississippi Department of Environmental Quality and/or the Mississippi Department of Health regulations and state laws.

Irrigation Equipment Inc.
 John P. Chism 0439
 Print Name of Water Well Contractor and License No. _____
 Signature of Water Well Contractor: John P. Chism

RECEIVED
 JUL 07 2009
 BY: OLWR

STATE WELL REPORT

Part 2

Pump Installer's Completion Report
 Mississippi Department of Environmental Quality
 Office of Land and Water Resources
 P.O. Box 10631
 Jackson, MS 39289-0631
 (601)961-5210
 (601)354-6938 (fax)

County: Sunflower
 Permit #: 60043208
 Irrigation Equipment
 Driller: _____
 Date completed: 6-30-09

For Office Use Only:

Aquifer: _____
 Well #: B122
 Elevation: _____

This report should be prepared by the pump installer in detail and filed with the Department within 30 days of the installation of pump.

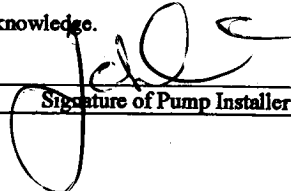
Well Owner Information	Well Location
Owner Name: <u>Lamar Berryhill</u> Mailing Address: <u>40 Berryhill Planting Co.</u> <u>P.O. Box 100</u> <u>Dublin Ms. 38739</u> <small>City State Zip Code</small>	Latitude: <u>33° 56' 59"</u> Longitude: <u>90° 29' 14"</u> Method of Lat/Long (circle one): Conventional Survey, USGS quad, Hand-held GPS, Survey-grade GPS <u>SE ¼ NE ¼ Sec 15 Twn 24N Rng 3W</u> Distance _____ Direction _____ Nearest Town _____ _____ Miles _____ of <u>Rome</u>
Telephone No. () _____	

Pump Type Circle one	Power Type Circle one
Air Lift Jet <u>Submersible</u> Bucket Piston Turbine Centrifugal Rotary Flowing Well Other (specify): _____ Date Pump Installed: <u>6-30-09</u> Rated Pump Capacity: <u>1100±</u> Gallons Per Minute	Diesel Engine Gasoline Engine Natural Gas <u>Electric Motor</u> Hand Tractor PTO Windmill Other (specify): _____ Horse Power Rating of Motor: <u>25</u> Setting Depth: <u>70</u> feet Number of Stages: <u>1</u>

Pump Test Data	Method of Measuring Water Level Circle one
Date Well Tested: _____ Static Water Level (A): _____ Feet Below Land Surface Pumping Water Level (B): _____ Feet Below Land Surface Drawdown [(B) - (A)]: _____ Feet Below Land Surface Test Pumping Rate: _____ Gallons Per Minute Duration of Pump Test (minimum 4 hours): _____ hours	Air Line Electric Measuring Line Steel Tape Other (specify): _____ For flowing well, measured shut in head: _____ feet Well yielded _____ GPM with a drawdown of _____ feet after _____ hours of pumping

I HEREBY CERTIFY that the above statements are true to the best of my knowledge.

John P. Chism 0439
 Print Name of Pump Installer and License No. (if applicable)

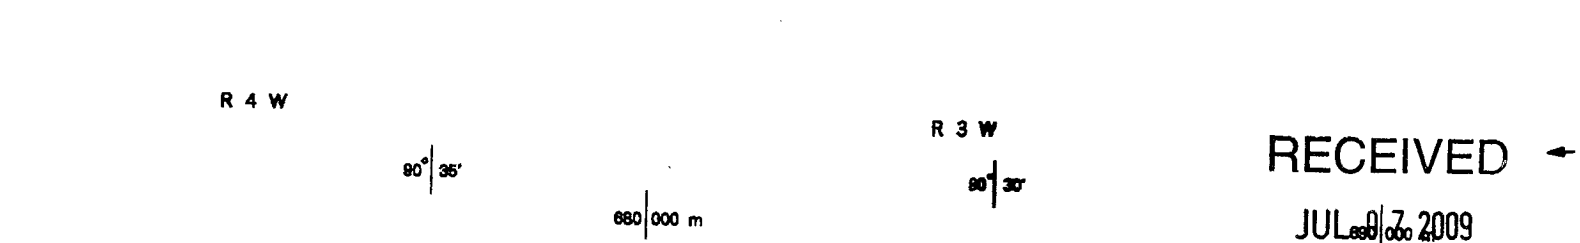
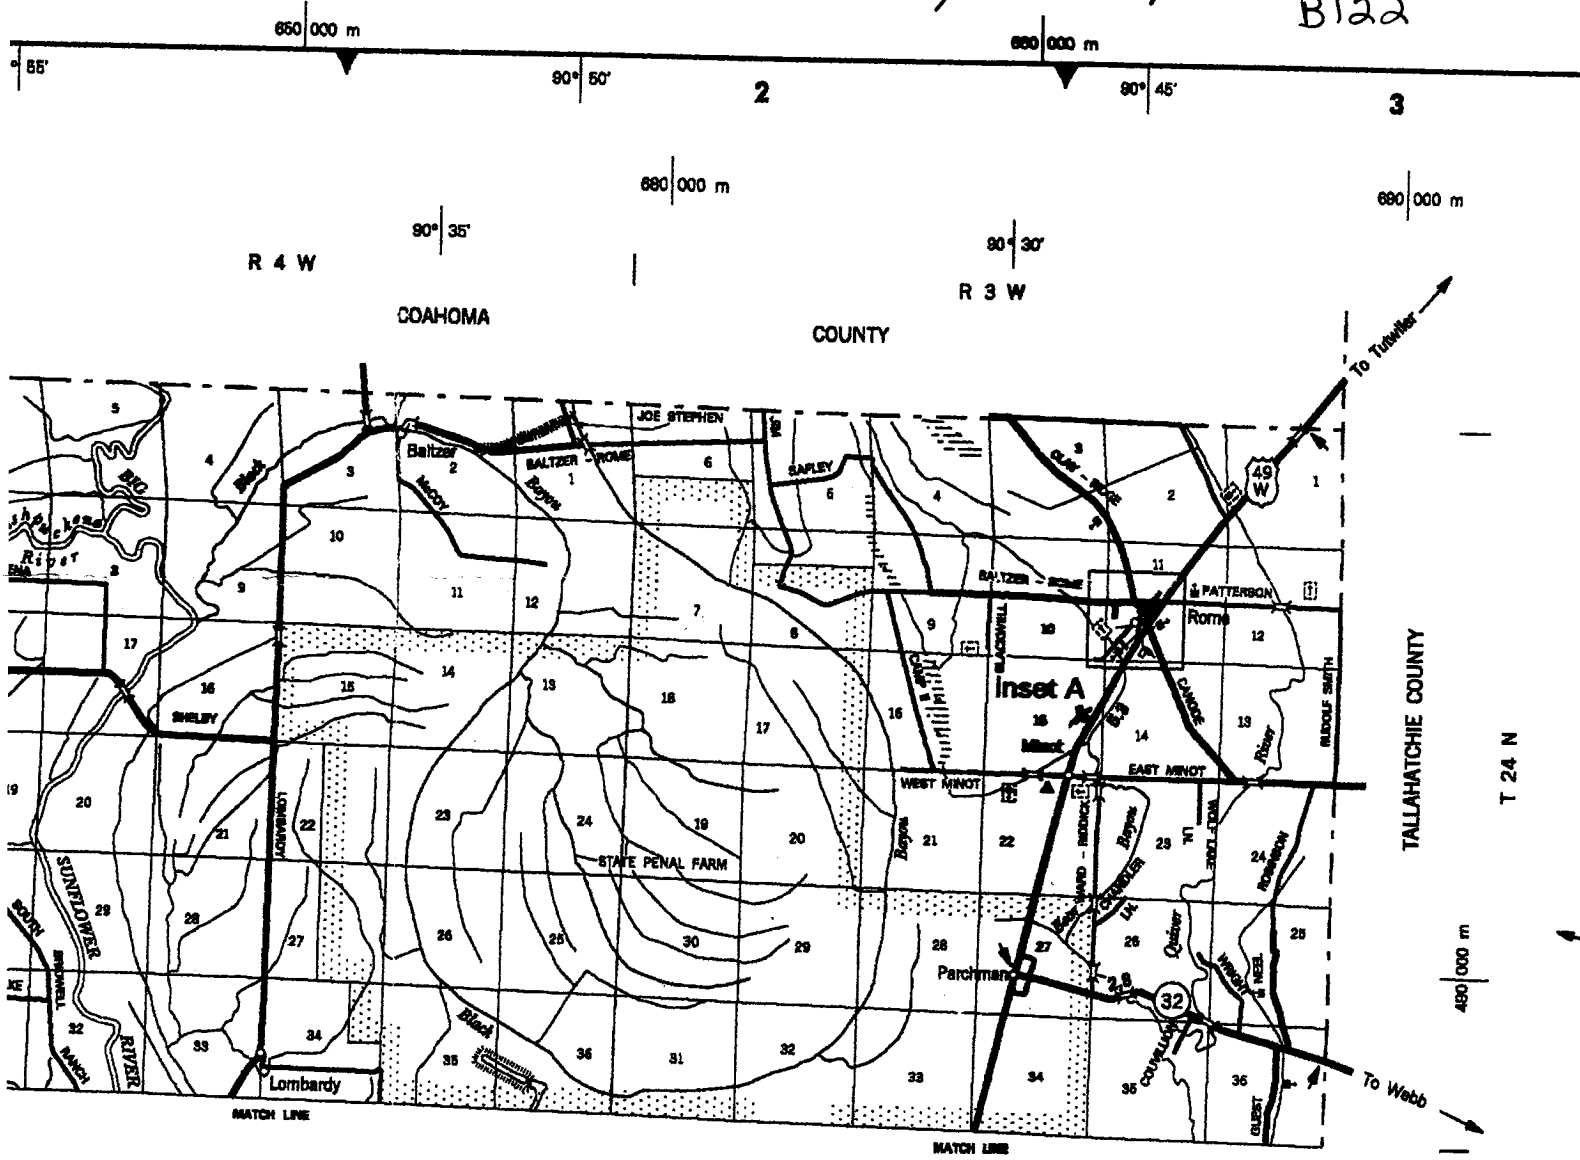

 Signature of Pump Installer

RECEIVED
 JUL 07 2009
 BY: OLWR

6643308

Lamar Berryhill Map

B122



- LUK C4
- LYON BRIDGE D3
- M.C. PUTTMAN A5
- MADSEN D4
- MAIN B3
- MAJORI E3
- MALLETT - JONES C4
- MAMIE LEE F4
- MARSHAN B2, F5
- MARY ST. B2
- MARSHALL F5
- MCKREY C5
- MCKREY C
- SOUTH WADE E1
- SOUTHSHIDE G4
- STAGGS C4
- STANSEL B6
- STEED - MOON D4
- STELMAN D6
- STEPHEN - LYON D8
- STEWART S4
- STINSON S4, F4
- STRINGFELLOW S4
- SUNFLOWER - ITTA BENA B5
- SUNFLOWER E4

RECEIVED
 JUL 7 2009
 BY: OLWR