

STATE WELL REPORT

Part 1

Driller's Log

Mississippi Department of Environmental Quality
Office of Land and Water Resources

P.O. Box 2309
Jackson, MS 39225-2309

(601)961-5210
(601)360-0535 (fax)

For Office Use Only:

Well #: B135

Aquifer: _____

E-Log #: _____

County: Sunflower
 Permit #: FW50013 ✓
 Driller: Chad Mattox
 Date drilling completed: 6/9/17

State Law requires that this report be prepared by the license holder responsible for the work and filed with the Department at the above address within 30 days of completion of drilling of the well or borehole.

Well Owner Information <small>(Landowner if borehole is not for a water well)</small>	Well or Borehole Location
Owner Name: <u>JAMERSON FARMS</u>	Latitude: <u>33 57 34</u> Longitude: <u>90 29 33</u>
Mailing Address: <u>PO Box 1016</u>	Method of Lat/Long (check one): Conventional Survey _____
	USGS quad _____, Hand-held GPS <input checked="" type="checkbox"/> , Survey-grade GPS _____
<u>BYHALIA</u> <u>MS</u> <u>38611</u>	<u>SW</u> ¼ <u>SE</u> ¼, Sec. <u>10</u> T <u>24N</u> R <u>03W</u>
City State Zip Code	<u>1</u> Miles <u>W</u> of <u>Rome</u>
Telephone No. (____) _____	(Distance) (Direction) (Nearest Town)

Well / Borehole Data
Date drilling started: <u>6/9/17</u> Date drilling completed: <u>6/9/17</u> Hole depth: <u>108</u> Hole diameter: <u>24"</u>
Location of the source of any surface water used for drilling: <u>nearby ditch</u>
Method of dosing and volume of Chlorine used in drilling and development: _____
Logs run (circle all applicable): No log run <input type="checkbox"/> Electric <input type="checkbox"/> Gamma Ray <input type="checkbox"/> Density <input type="checkbox"/> Sonic <input type="checkbox"/> Neutron <input type="checkbox"/> Other: _____
Name of organization running log(s): _____
Purpose of borehole (circle one): <u>Water Well</u> Geotechnical/Geological Investigation _____ Ground Source Heat Pump _____ Seismic Survey _____ Other (describe) _____
<i>If drilling is not related to water well construction, skip the remainder of this block</i>
Purpose of Well (circle all applicable): Home _____ Industrial _____ Public Supply _____ <u>Irrigation</u> _____ Fish Culture _____
Other (describe): _____
If a flowing well, method of flow regulation: Valve _____ Other (describe) _____
Static Water Level: <u>15</u> feet [above or <u>(below)</u> land surface] Date measured: <u>6/9/17</u> <small>(circle one)</small>
Method of measurement (circle one): <u>Steel tape</u> Electric tape _____ Air line _____ Other (describe): _____
Well depth: <u>108</u> Well grouted to a depth of: <u>10</u> feet Type of grout (circle one): Neat Cement _____ Bentonite _____ Mix _____
Casing length: <u>68</u> feet Casing diameter: <u>16"</u> inches Type of casing: <u>PVC</u>
Screen length: <u>40</u> feet Screen diameter: <u>16"</u> inches Type of screen: <u>PVC</u>
Screen slot size: <u>.050</u> inches Setting depth: From <u>68</u> feet to <u>108</u> feet
Type of completion (circle all applicable): <u>Gravel packed</u> Underreamed _____ Open hole _____ Natural Development _____
Other (describe): _____
Top of lap pipe or reduction in casing: _____ feet
<i>If telescoped or more than one screen, describe on next page</i>

STATE WELL REPORT

Part 2

Pump Installer's Completion Report
 Mississippi Department of Environmental Quality
 Office of Land and Water Resources
 P.O. Box 2309
 Jackson, MS 39225-2309
 (601)961-5210
 (601) 360-0535 (fax)

County: SUNFLOWER
 Permit #: GW 50013 ✓
 Driller: CHAD MATTOX
 Date completed: 6-9-17
Copy information from block on Part 1

For Office Use Only:

Well #: B135
 Aquifer: _____

This part of the report must be completed by a licensed water well contractor, or a licensed pump installer. A copy of Part 1 of the report must be attached and both parts filed with the Department at the above address within 30 days of well completion.

Well Owner Information	Well Location
Owner Name: <u>WATSON BAYOU FARM, INC</u>	Latitude: <u>33°57'34"</u> Longitude: <u>90°29'33"</u>
Mailing Address: <u>875 W POPLAR AVE</u>	Method of Lat/Long (check one): Conventional Survey _____, USGS quad _____, Hand-held GPS _____, Survey-grade GPS _____
<u>COLLIARVILLE</u> <u>TN</u> <u>38017</u>	<u>SW</u> ¼ <u>SE</u> ¼, Sec <u>10</u> T <u>24N</u> R <u>03W</u>
City State Zip Code	<u>3/4</u> Miles <u>W</u> of <u>ROME</u>
Telephone No: <u>(901) 487-8774</u>	(Distance) (Direction) (Nearest Town)

Pump Type (circle one)

Submersible Turbine Air Lift Centrifugal Flowing Well Jet Piston Rotary Other (describe): _____

Date Pump Installed: 7-12-17 Rated Pump Capacity: 1100 Gallons Per Minute

Is This Pump (circle one): New Repaired Replacement

Power Type (circle one)

Electric Diesel Gasoline Natural Gas Tractor PTO Windmill Other (describe): _____

Horse Power Rating of Motor: 60 Setting Depth: 60 feet Number of Stages: 3

Pump Test Data for Non Flowing Well

Date Well Tested: _____ Duration of Pump Test (minimum 4 hours): _____ hours

Static Water Level (A): 15 Feet Below Land Surface Pumping Water Level (B): _____ Feet Below Land Surface

Drawdown [(B) - (A)]: _____ Feet Below Land Surface Test Pumping Rate: _____ Gallons Per Minute

Method of measurement (circle one): Steel tape Electric tape Air line Other (describe): _____

Pump Test Data for Flowing Well

Measured shut in head: _____ feet.

Well yielded _____ GPM with a drawdown of _____ feet after _____ hours of pumping

Meter Installation

Meter Manufacturer: _____ Meter Serial Number: _____

Meter Model Number/Name: _____ Type of Meter: AUG 07 2017

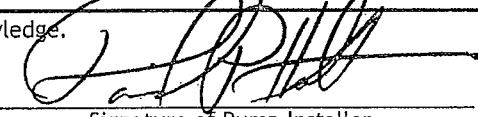
Totalizer Register Unit and Multiplier Factor (AF x .001, gal x 1000, etc): _____

Installation Date: _____ Meter installed by: BY OLWR

Is This Meter (circle one): New Repaired Replacement

Important: By submitting the above information you are certifying that this meter was installed to manufacturer standards. For agricultural wells, a list of approved meters is on the MDEQ website.

I HEREBY CERTIFY that the above statements are true to the best of my knowledge.

DAVID P. HOLT 0-752P 8-3-17 

Print Name of Pump Installer and License No. (if applicable) Date Signature of Pump Installer

17.0301