

County: San Flower
 Permit #: MS-CW-49603
 Driller: TEDDY LEADS
 Date drilling completed: 12-13-16

State Well Report
 Part I - Driller's Log
 Mississippi Department of Environmental Quality
 Office of Land and Water Resources
 P.O. Box 2309
 Jackson, MS 39225
 (601)961- 5210
 (601)961- 5228 (fax)

For Office Use Only:
 Aquifer: _____
 Well #: B138
 L. S. Elevation: _____
 E-log #: _____

State Law requires that this report be prepared by the license holder responsible for the work and filed with the Department at the above address within 30 days of completion of drilling of the well or borehole.

Information on Well Owner
 (Landowner if borehole is not for a water well)
 Owner Name MS Dept. of Corrections
 Mailing Address: P.O. Box 639
Parchman MS 38738
 City State Zip Code
 Telephone No. () _____

Well or Borehole Location
 Latitude: 33° 55' 16" N Longitude: 90° 30' 24" W
 Method of Lat/Long (circle one): Conventional Survey,
 USGS quad, Hand-held GPS, Survey-grade GPS
NE 1/4 SE 1/4 Sec 28 Twn 24 N Rng 03 W
 SE NE
 Distance Direction Nearest Town
1/4 Miles N of Parchman

Well / Borehole Data
 Date drilling started: 12-13-16 Date drilling completed: 12-13-16 Hole depth: 116 Hole diameter: 28
 Location of the source of any surface water used for drilling: Nearest well
 Method of dosing and volume of Chlorine used in drilling and development: _____
 Logs run (circle all applicable): No log run Electric Gamma Ray Density Sonic Neutron Other: _____
 Name of organization running log(s): _____
 Purpose of borehole (check one): Water Well Geotechnical/Geological Investigation _____ Ground Source Heat Pump _____
 Seismic Survey _____ Other (describe) _____
 If drilling is not related to water well construction, ship the remainder of this block

Purpose of Well (check one): Home _____ Industrial _____ Public Supply _____ Irrigation Fish Culture _____ Other: _____
 If a flowing well, method of flow regulation: Valve _____ Other (describe) _____
 Static Water Level: 20 feet above or below (circle one) land surface Date measured: 12-13-16
 Method of Measurement (circle one) steel taps electric tape air line other: _____
 Well depth: 116 Well grouted to a depth of 10 feet Type of grout (circle one): Neat Cement Bentonite Mix
 Casing length: 76 feet Casing diameter: 16 inches Type of casing: P.V.C
 Screen length: 40 feet Screen diameter: 16 inches Type of screen: P.V.C
 Screen slot size: 050 inches Setting depth: From 0 feet to 70 feet
 Type of completion (circle all applicable): Gravel packed Underreamed Telescoped Open hole Natural Development
 Other (describe): _____
 Top of lap pipe or reduction in casing: _____ feet. If telescoped or more than one screen, describe on next page

Form: OLWR-SWR-1A (04/08)



RECEIVED
 JAN 10 2017
 OLWR

33 55 16n 90 30 24w
near Drew



Page 1 of 1
Printed from my iPhone

Drew, MS 38737
Drew, MS 38737
United States

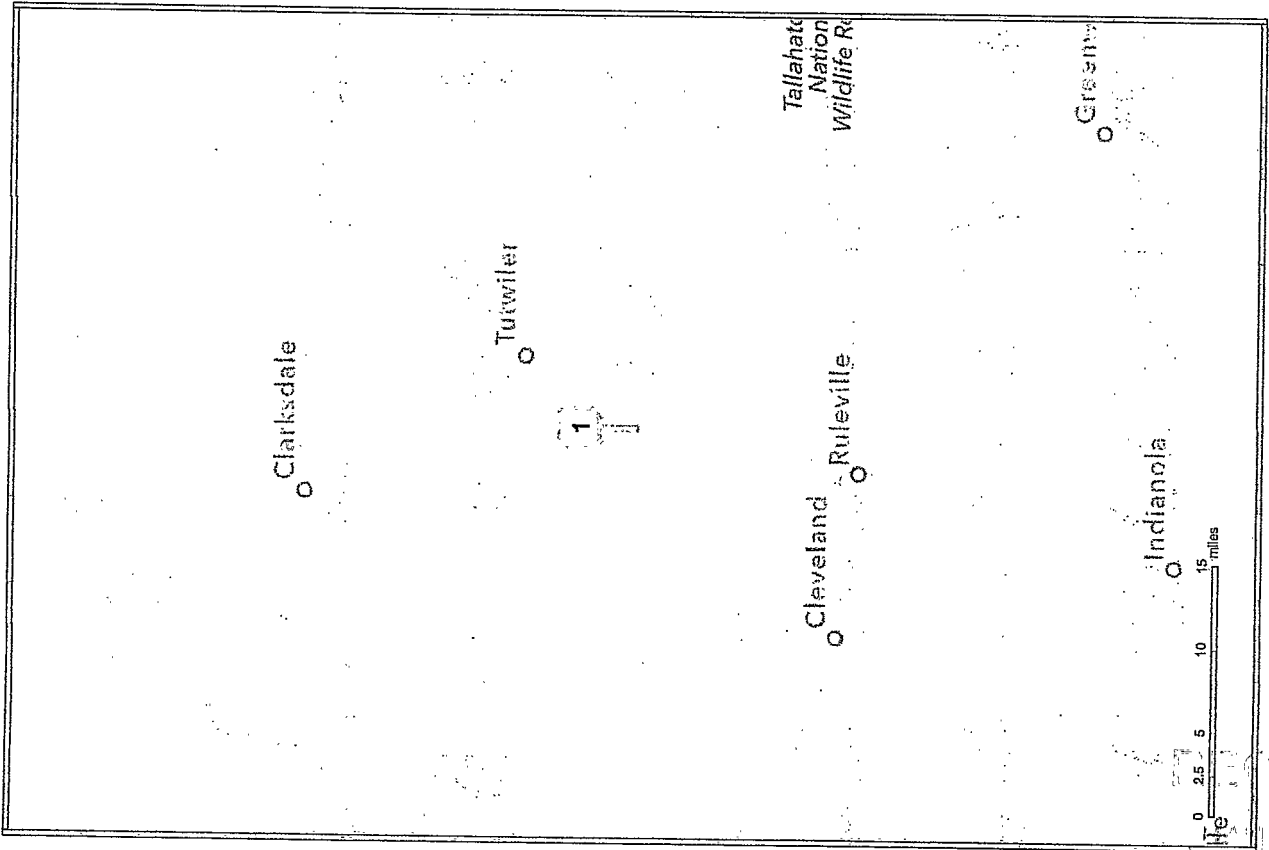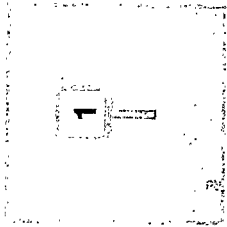

B138

BY OLWA

STATE WELL REPORT

Part 2

Pump Installer's Completion Report
 Mississippi Department of Environmental Quality
 Office of Land and Water Resources
 P.O. Box 2309
 Jackson, MS 39225
 (601)961-5210
 (601)961-5228 (fax)

County: Sunflower
 Permit #: MS. 6W-49603
 Driller: TEDDY Coats
 Date completed: 12-13-16
Copy information from block on Part 1

For Office Use Only:

Aquifer: _____
 Well #: B138
 Elevation: _____

This part of the report must be completed by a licensed water well contractor or a licensed pump installer. A copy of Part 1 of the report must be attached and both parts filed with the Department at the above address within 30 days of well completion.

Well Owner Information	Well Location
Owner Name: <u>MS, Dept of correction</u>	Latitude: <u>33 55 16^N</u> Longitude: <u>90 30 29^W</u>
Mailing Address: _____ <u>PO. Box 639</u> <u>Parchman MS 38738</u> <small>City State Zip Code</small>	Method of Lat/Long (check one): Conventional Survey _____ USGS quad _____, Hand-held GPS <input checked="" type="checkbox"/> , Survey-grade GPS _____ <u>NE 1/4 SE 1/4 Sec 28 T24N R03W</u> Distance <u>SE NE</u> Direction Nearest Town <u>1/4</u> Miles <u>N</u> of <u>Parchman</u>
Telephone No. () _____	

Pump Type Circle one	Power Type Circle one
Air Lift Jet Submersible	<input checked="" type="radio"/> Diesel Engine Gasoline Engine Natural Gas
Bucket Piston <input checked="" type="radio"/> Turbine	Electric Motor Hand Tractor PTO
Centrifugal Rotary Flowing Well	Windmill Other (specify): _____
Other (specify): _____	Horse Power Rating of Motor: <u>60 HP</u>
Date Pump Installed: <u>12-13-16</u>	Setting Depth: <u>0-70</u> feet
Rated Pump Capacity: <u>2500</u> Gallons Per Minute	Number of Stages: <u>2-stage</u>

Pump Test Data	Method of Measuring Water Level Circle one
Date Well Tested: <u>12-13-16</u>	Air Line Electric Measuring Line <input checked="" type="radio"/> Steel Tape
Static Water Level (A): <u>20</u> Feet Below Land Surface	Other (specify): _____
Pumping Water Level (B): <u>40</u> Feet Below Land Surface	For flowing well, measured shut in head: _____ feet
Drawdown [(B) - (A)]: <u>20</u> Feet Below Land Surface	Well yielded _____ GPM with a drawdown of _____ feet after _____ hours of pumping
Test Pumping Rate: <u>2500</u> Gallons Per Minute	
Duration of Pump Test (minimum 4 hours): <u>4</u> hours	

I HEREBY CERTIFY that the above statements are true to the best of my knowledge.

TEDDY Coats #5318 Teddy Coats
 Print Name of Pump Installer and License No. (if applicable) Signature of Pump Installer

RECEIVED
 Form: OLWR-SWR-1B (04/08)

JAN 10 2017
 BY OLWR