

C 8  
4-6-61

WATER WELL DRILLERS LOG

**CODED**

Date: 4/6, 1961, Driller: Delta Well Supply Co County Lumpkin  
(Name)

(1) Owner of Land: W.H. Ketterer  
(Name)  
Minwood  
(Address)

(2) Location: 1/4, N 1/4, Sec. 19 T23R4  
4 miles East, of Minwood  
(distance) (direction) (Nearest Town)

(3) Topography: Flat  
(Hilly) (Flat) (Level)

(4) Purpose of Well:  
(Domestic Irrigation  
Municipal, Industrial, Other)

Description & Color of Materials Sand, Clay, Red Clay, Shell, etc.	Thick- ness Feet	Depth Feet
<u>Top soil &amp; gravel</u>	<u>21</u>	<u>21</u>
<u>Fine sand &amp; clay break</u>	<u>55</u>	<u>76</u>
<u>Sand &amp; gravel</u>	<u>30</u>	<u>106</u>
<u>Bottom of well on Rock!</u>		

Information upon completion of well:

(1) Diameter 12 inches.

(2) Total Depth 106 feet.

(3) Water Level 22 feet below top of ground.

(4) Cased to \_\_\_\_\_, Size \_\_\_\_\_

(5) Screen: Size 12, Length 39


(6) Were any formations sealed against pollution?  
\_\_\_\_\_ yes,  no.

**CODED**

If YES depth of formation \_\_\_\_\_

Why \_\_\_\_\_

Drillers Remarks: \_\_\_\_\_

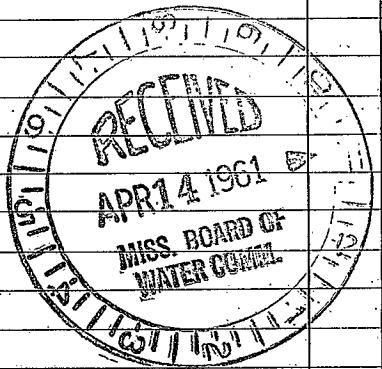

(Use Back Side)

Well No.

