

BC 12
1-3-63

WATER WELL DRILLERS LOG

CODED

sunflower
Humboldt

Date: Jan 3, 1963, Driller: Robert E. Raloff County Humboldt
(Name)

(1) Owner of Land: A.C. Tidmore
(Name)
New Miss.
(Address)

(2) Location: 1/4, 1/4, Sec. 25 T 23 R 4
_____ miles _____ of _____
(distance) (direction) (Nearest Town)

(3) Topography: _____
(Hilly) (Flat) (Level)

(4) Purpose of Well: Domestic
(Domestic Irrigation
Municipal, Industrial, Other)

Description & Color of Materials Sand, Clay, Red Clay, Shell, etc.	Thick- ness Feet	Depth Feet
0-24 Gunbo		
24-48 Gunbo streaks		
48-72 sand clay "		
72-119 sand gravel		
119-166 gravel		
166-187 gravel sand		
187-190 Gunbo		
190-214 Gunbo rock, 12'		
214-262 sand		
262-392 sand shale streak		
392-498 shale		
498-599 Gunbo		
599-616 fine sand		
616-639 sandy shale		
639-662 sand fine		
662-685 sand grad.		
685-708 sand grad.		

Information upon completion of well:

(1) Diameter 4 1/2 inches.

(2) Total Depth 708 feet.


(3) Water Level 24' feet below top of ground.

(4) Cased to 708, Size 4 1/2

(5) Screen: Size 2", Length 10

(6) Were any formations sealed against pollution?
_____ yes, _____ no.

CODED

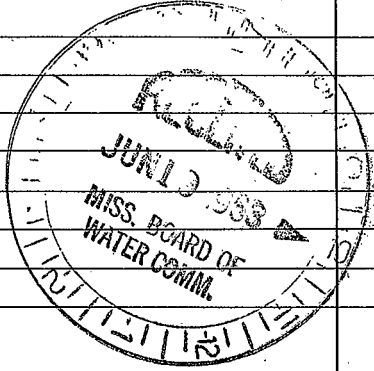

(Use Back Side)

Well No.

