

SUNFLOWER
 C13
 3-10-72

MISSISSIPPI
 BOARD OF WATER COMMISSIONERS
 416 North State Street
 Jackson, Mississippi 39201
 CODED MAR 21 1972

WATER WELL DRILLERS LOG

march 10 1972 date well completed
 Cleveland Drilling & Supply firm name
 Sunflower county well located

LANDOWNER:
 Adrien Hollingsworth
 Merigold Farms RFD
 (mailing address)

WELL LOCATION:
 sec. 24 T. 23 N. R. 4 E
 6 miles East of Newell
 (distance) (direction) (nearest town)

WELL PURPOSE: Home
 (home, irrigation, municipal, industrial)

WELL COMPLETION DATA:

(1) diameter (inches) 4" x 7"
 (2) total depth (feet) 587
 (3) static water level (feet) 30' below top of ground.
 (4) casing Galvalume 567' (material) (depth)
 (size) If telescope see back.
 (5) screen 20' 567' (length) (depth to top)
 2" S.S. (size) (material)
 (6) pump 1/2 HP 70 (yield gpm)
 (type power)
 (7) electric log (yes or no)
 (organization running log)
 (8) how well bottom plugged Wash out valve


description of formations encountered	from	to
Clay	18'	18'
Clay	18'	190'
Clay	190'	220'
Clay	220'	280'
Clay	280'	530'
Clay	530'	600'

CODED

DRILLERS REMARKS:

If well telescopes please sketch and show depths.

GROUND LEVEL

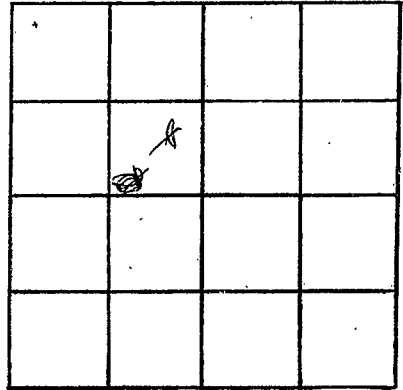

SECTION 34

Please indicate well location X.

ADDITIONAL INFORMATION

If more than one screen,
show locations of each on sketch.