

SUNFLOWER
C14
5-5-73

MISSISSIPPI
 BOARD OF WATER COMMISSIONERS
 416 North State Street
 Jackson, Mississippi 39201

CODED

WATER WELL DRILLERS LOG

5/5 1973
 date well completed

Walter D. Supply
 firm name

Sumner
 county well located

LANDOWNER:

Partners Bros.
St. Merigold, Miss.
 (mailing address)

description of formations encountered

from to

<u>Top Soil</u>	<u>0</u>	<u>16</u>
<u>Fine Sand</u>	<u>16</u>	<u>36</u>
<u>Coarse Sand</u>	<u>34</u>	<u>96</u>
<u>Sand Rocks</u>	<u>96</u>	<u>?</u>

WELL LOCATION:

sec. 19 T 23 N R. 4 E
4 miles East Merigold
 (distance) (direction) (nearest town)

WELL PURPOSE: irrigation
 (home, irrigation, municipal, industrial)

WELL COMPLETION DATA:

- (1) diameter (inches) 12"
- (2) total depth (feet) 96 ft.
- (3) static water level (feet) 24 below above top of ground.
- (4) casing Steel, 12
 (material) (depth)

(size) If telescope see back.

- (5) screen 34 ft 62 ft
 (length) (depth to top)
- 12 Steel
 (size) (material)

- (6) pump 30 2000
 (HP) (yield gpm)
- Direct
 (type power)

- (7) electric log No
 (yes or no)

(organization running log)

- (8) how well bottom plugged Cement


DRILLERS REMARKS:

CODED

5/11/73

If well telescopes please sketch and show depths.

GROUND LEVEL

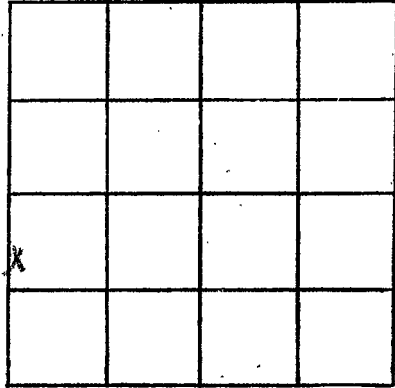

SECTION 19

Please indicate well location X.

ADDITIONAL INFORMATION

If more than one screen,
show locations of each on sketch.