

SUNFLOWER
~~ABCIS~~
 03-7-73

MISSISSIPPI
 BOARD OF WATER COMMISSIONERS
 416 North State Street
 Jackson, Mississippi 39201

CODED

WATER WELL DRILLERS LOG

C17029

March 7, 1973 Singer-Layne Central Division Sufflower
 date well completed firm name county well located

LANDOWNER: Parker Planting Co
 Drew, Mississippi
 (mailing address)

description of formations encountered	from	to
	Clay	0
Fine sand	30	40
Coarse sand, pea gravel	40	107
Clay		107

WELL LOCATION:
 sec. 2 T. 20 N R. 4 E
 X&X W
 south of Camp 4 of Parchman
 (distance) (direction) (nearest town)

WELL PURPOSE: Irrigation
 (home, irrigation, municipal, industrial)

WELL COMPLETION DATA:


- (1) diameter (inches) 16
- (2) total depth (feet) 107
- (3) static water level (feet) 13' below top of ground.
- (4) casing steel 57'
 (material) (depth)
 16" if telescope see back.
 (size)
- (5) screen 50' 107'
 (length) (depth to top)
 16" Doer
 (size) (material)
- (6) pump 60 3000
 (HP) (yield gpm)
 Engine 0
 (type power)
- (7) electric log no
 (yes or no)
 (organization running log)
- (8) how well bottom plugged plate

CODED

DRILLERS REMARKS:

If well telescopes please sketch and show depths.

GROUND LEVEL

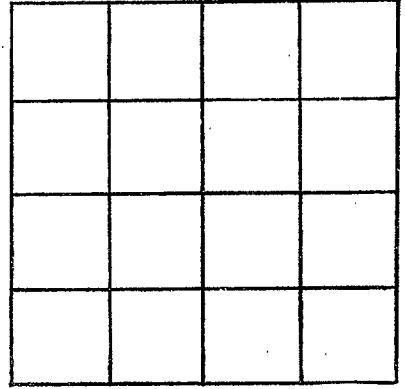

SECTION _____

Please indicate well location X.

ADDITIONAL INFORMATION

If more than one screen, show locations of each on sketch.