

SUNFLOWER
C 16
3-15-75

MISSISSIPPI
BOARD OF WATER COMMISSIONERS
416 North State Street
Jackson, Mississippi 39201

CODED

WATER WELL DRILLERS LOG

March 15, 1975 Dyer-Sullivan, Inc. Sunflower
date well completed firm name county well located

LANDOWNER: Prudential Life Ins. #1
Suite 513 White Station Tower
5050 Poplar Ave. Memphis, Tenn. 38157
(mailing address)

description of formations encountered	from	to
Clay	0	33
FINE SAND	33	71
SAND + GRAVEL	71	111

WELL LOCATION:
sec. 29 T. 23 N. R. 4 E. 15 H.
6 miles NW of Dew
(distance) (direction) (nearest town)

WELL PURPOSE: Irrigation
(home, irrigation, municipal, industrial)

WELL COMPLETION DATA:


- (1) diameter (inches) 16"
- (2) total depth (feet) 111'
- (3) static water level (feet) 10' below top of ground.
- (4) casing BIC Iron, 71' (material) (depth)
16" (size) if telescope see back.
- (5) screen 40' (length), 71' (depth to top)
16" BIC Inset (size) (material)
- (6) pump 1/2 HP, 3000 (type power) (yield gpm)
- (7) electric log no (yes or no)
- (8) how well bottom plugged Plate

DRILLER'S SIGNATURE
OCT 12 1975

DRILLERS REMARKS:

If well telescopes please sketch and show depths.

GROUND LEVEL

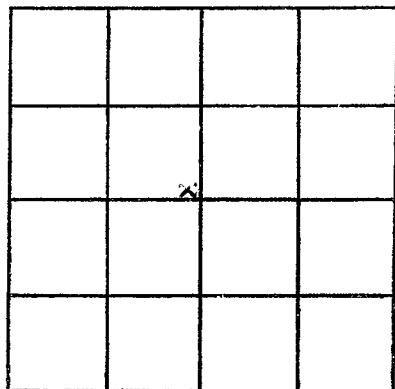

SECTION 29

Please indicate well location X.

ADDITIONAL INFORMATION

If more than one screen, show locations of each on sketch.