

Sun Flower
C 19
5/10/81

MISSISSIPPI DEPARTMENT OF NATURAL RESOURCES
Bureau of Land and Water Resources
Southport Mall
P.O. Box 10631
Jackson, Mississippi 39209
WATER WELL DRILLERS LOG

CODED

May 10 1981 date well completed
Larry's well & pump firm name
Sunflower county well located

LANDOWNER: Tom Hester	description of formations encountered	from	to
Shelby Ms. (mailing address)	Clay	0	29
	Fine Sand	29	55
	Coarse Sand	55	116

WELL LOCATION:
sec. 25 T 23 N R 4 E
6 miles NW of Drew
(distance) (direction) (nearest town)

WELL PURPOSE:
(home, irrigation, municipal, industrial)

- WELL COMPLETION DATA:
- (1) diameter (inches) 16"
 - (2) total depth (feet) 116'
 - (3) static water level (feet) 21 below top of ground.
 - (4) casing Steel, 76' (material) (depth)
 - (size) If telescope see back.
 - (5) screen 40' 76' (length) (depth to top)
 - 16" Steel (size) (material)
 - (6) pump 100 3000 (HP) (yield gpm)
 - (type power)
 - (7) electric log No (yes or no)
 - (organization running log)
 - (8) how well bottom plugged Steel Plate

CODED

DEPT. OF NATURAL RESOURCES
BUREAU OF LAND & WATER RESOURCES


OCT 15 1981

RECEIVED

DRILLERS REMARKS:

If well telescopes please sketch and show depths.

GROUND LEVEL

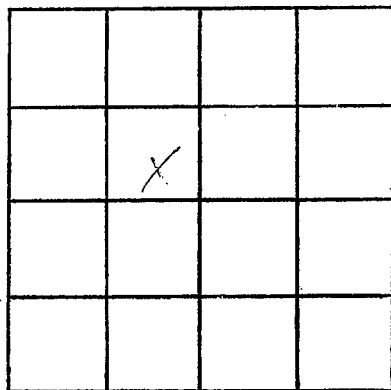

SECTION 25

Please indicate well location X.

ADDITIONAL INFORMATION

If more than one screen, show locations of each on sketch.