

Sunflower
C 31
7-11-69

MISSISSIPPI
BOARD OF WATER COMMISSIONERS
416 North State Street
Jackson, Mississippi 39201

CODED

WATER WELL DRILLERS LOG

DYER WELL & IRRIGATION SERVICE SUNFLOWER

July 11 1969 date well completed firm name county well located

LANDOWNER:
J.O. DOCKERY
DOCKERY, MRS.
(mailing address)

WELL LOCATION:
sec. 11 T 23 N R. 4 W
6 miles NW of DREW
(distance) (direction) (nearest town)

WELL PURPOSE: IRRIGATION
(home, irrigation, municipal, industrial)

WELL COMPLETION DATA:
(1) diameter (inches) 16"
(2) total depth (feet) 106'
(3) static water level (feet) 19 below above top of ground.
(4) casing BLUE IRON, 66'
(material) (depth)
16" (size) If telescope see back.
(5) screen 40', 66'
(length) (depth to top)
16" BLUE IRON
(size) (material)
(6) pump 60 2000
(HP) (yield gpm)
Diesel
(type power)
(7) electric log No
(yes or no)
(organization running log)
(8) how well bottom plugged PLATE

description of formations encountered	from	to
Clay	0	13
Clay + fine sand.	13	23
fine sand.	23	33
Blue Clay	33	43
Coarse sand	43	53
Med sand	53	63
Coarse sand	63	73
✓ ✓ ✓ gravel	73	83
✓ ✓ ✓	83	93
✓ ✓ ✓	93	103
✓ ✓ ✓	103	106

CODED


JUL 23 1969

DRILLERS REMARKS:

MISS. BD. OF
WATER COM.

If well telescopes please sketch and show depths.

GROUND LEVEL

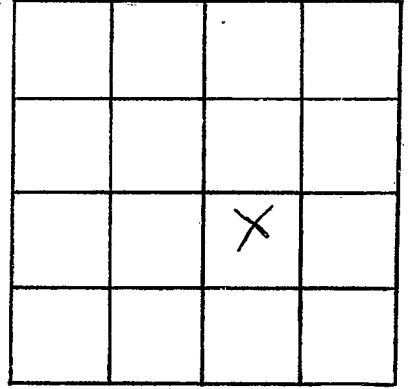

SECTION M

Please indicate well location X.

ADDITIONAL INFORMATION

If more than one screen, show locations of each on sketch.