

Sandflower
~~C 32~~ 32
 6-9-69

MISSISSIPPI
 BOARD OF WATER COMMISSIONERS
 416 North State Street
 Jackson, Mississippi 39201

CODED

WATER WELL DRILLERS LOG

619 date well completed 1969 Delta Well Drilling Co firm name Sandflower county well located

LANDOWNER:

Patterson Bros.

Merigold Miss.
 (mailing address)

WELL LOCATION:

sec. 20 T. 23 N. R. 4 E. W. X
4 miles East of Merigold
 (distance) (direction) (nearest town)

WELL PURPOSE: *Irrigation*
 (home, irrigation, municipal, industrial)

WELL COMPLETION DATA:

- (1) diameter (inches) 16
- (2) total depth (feet) 138
- (3) static water level (feet) 23 below above top of ground.
- (4) casing, steel (material) (depth)
- _____ If telescope see back. (size)
- (5) screen 36 / 102 (length) (depth to top)
- 16 / steel (size) (material)
- (6) pump 25 / 1500 (HP) (yield gpm)
- 3hp (type power)
- (7) electric log no (yes-or no)

_____ (organization running log)

(8) how well bottom plugged Concrete

description of formations encountered

from to

<i>Top Soil & clay</i>	0	26
<i>Sand & shells</i>	26	32
<i>Blue Clay</i>	32	83
<i>Sand & gravel</i>	83	97
<i>Brown gravel & clay</i>	97	100
<i>Hard Rock</i>	100	101
<i>Sand & sea shell</i>	101	138


JUN 30 1969

MISS. RD. OF
 WATER COMM.

DRILLERS REMARKS:

If well telescopes please sketch and show depths.

GROUND LEVEL

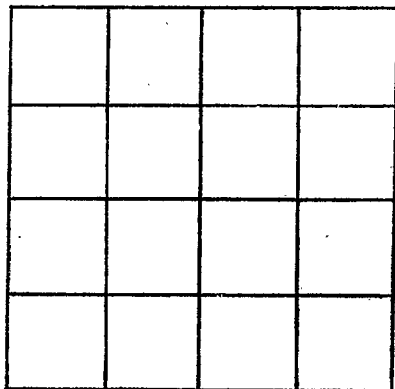

SECTION 20

Please indicate well location X.

ADDITIONAL INFORMATION

If more than one screen,
show locations of each on sketch.