

SUNFLOWER

C 33

12-4-70

MISSISSIPPI BOARD OF WATER COMMISSIONERS
416 North State Street
Jackson, Mississippi 39201

CODED

WATER WELL DRILLERS LOG

12-4
date well completed

1970 Delta Well Supply
firm name

Sunflower
county well located

LANDOWNER:

Sayer, A Dyle

description of formations encountered

from

to

Rt. 1 Box 60
Merigold, Miss
(mailing address)

Clay 0 16
Sand + Rockwood 16 105

WELL LOCATION:

sec. 29 T 23 N R 4 E
5 miles East of Merigold
(distance) (direction) (nearest town)

Clay 105 112
Sand 112 170

WELL PURPOSE:

Home
(home, irrigation, municipal, industrial)

Clay 170 174
Sand 174 244

WELL COMPLETION DATA:

- (1) diameter (inches) 4" x 2"
- (2) total depth (feet) 73 1/2
- (3) static water level (feet) _____ below top of ground.
- (4) casing Galv (material), _____ (depth)

Sand 244 265
Shale 265 306

_____ If telescope see back.
(size)

- (5) screen 20 (length), _____ (depth to top)
2" (size), Stainless (material)

Sand 306 326
Sandy Shale 326 346
Sand w streaks of shale 346 446

- (6) pump 1 (HP), 25 (yield gpm)

Ele (type power)

Humus shale 446 520
Sand 520 750

- (7) electric log no (yes or no)

(organization running log)

- (8) how well bottom plugged

CODED

DEC 16 1970

DRILLERS REMARKS

Schultz


MISS. BD. OF WATER COMMISSIONERS

If well telescopes please sketch and show depths.

GROUND LEVEL

20 ft | 538 ft | 186 ft
Screens | | |
| | |

If more than one screen, show locations of each on sketch.

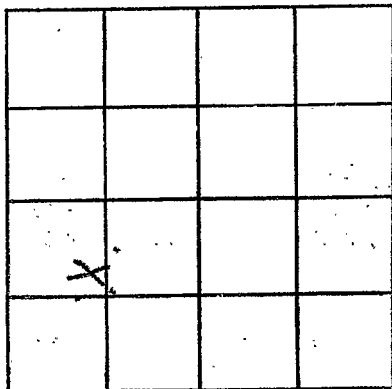

SECTION 29

Please indicate well location X.

ADDITIONAL INFORMATION

Lined area for additional information.