

SUNFLOWER
C 34
2-11-71

MISSISSIPPI
 BOARD OF WATER COMMISSIONERS
 416 North State Street
 Jackson, Mississippi 39201

CODED

WATER WELL DRILLERS LOG
DYER WELL & IRRIGATION SERVICE *SUNFLOWER.*
 date well completed 2/11/71 19 71 firm name county well located

LANDOWNER:
W. O. Shurder
DREW, miss,
 (mailing address)

description of formations encountered	from	to
<u>CLAY</u>	<u>0</u>	<u>15</u>
<u>SAND</u>	<u>15</u>	<u>65</u>
<u>GRAVEL</u>	<u>65</u>	<u>102</u>

WELL LOCATION:
 sec. 23 T 23 N R 9 E
4 miles N.W. of DREW
 (distance) (direction) (nearest town)

WELL PURPOSE: CATTLE
 (home, irrigation, municipal, industrial)

- WELL COMPLETION DATA:**
- (1) diameter (inches) 2"
 - (2) total depth (feet) 94'
 - (3) static water level (feet) 20' ^(below) above top of ground.
 - (4) casing 2" low 84'
 (material) (depth)
2" if telescope see back.
 (size)
 - (5) screen 10' 84'
 (length) (depth to top)
2" PLASTIC
 (size) (material)
 - (6) pump 1 10
 (HP) (yield gpm)
Electric
 (type power)
 - (7) electric log No
 (yes or no)
- (organization running log)
- (8) how well bottom plugged DACY
WAS HUALUC

CODED


MAR 22 1971

DRILLERS REMARKS:

MISS. BD. OF
 WATER COMMISSIONERS

If well telescopes please sketch and show depths.

GROUND LEVEL

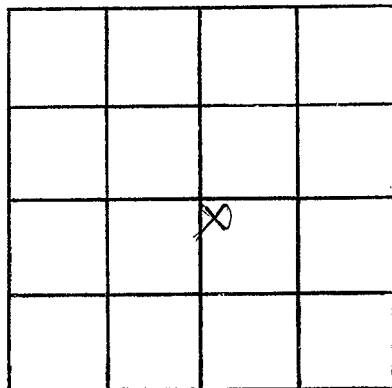

SECTION 23

Please indicate well location X.

ADDITIONAL INFORMATION

If more than one screen, show locations of each on sketch.