

SUNFLOWER
C35
3-3-71

MISSISSIPPI
BOARD OF WATER COMMISSIONERS
416 North State Street
Jackson, Mississippi 39201

CODED

WATER WELL DRILLERS LOG

BUTANE GAS CO. OF GREENWOOD

POST OFFICE BOX 1135

GREENWOOD, MISS. 39300

Sunflower

3-3-71 19
date well completed

county well located

LANDOWNER:
Leslie Dixon
Drew Miss
(mailing address)

WELL LOCATION:
sec. 31 T. 23 N R. 4 E
6 1/2 miles W of Drew
(distance) (direction) (nearest town)

WELL PURPOSE: farm
(home, irrigation, municipal, industrial)

WELL COMPLETION DATA:

(1) diameter (inches) 4 x 2

(2) total depth (feet) _____

(3) static water level (feet) 18 below above top of ground.

(4) casing Steel, 6 7/8,
(material) (depth)
4 x 2 if telescope see back.
(size)

(5) screen 20', 6 7/8
(length) (depth to top)
2", Stainless Steel
(size) (material)

(6) pump 1, 15
(HP) (yield gpm)
Elec.
(type power)

(7) electric log no
(yes or no)

(organization running log)

description of formations encountered	from	to
Clay	0	18
SAND	18	120
SAND + GRAVEL	120	140
SAND	140	285
CLAY	285	388
SHALE	388	415
CLAY	415	532
SAND	532	590
SAND	590	617
SAND + CLAY	617	670
SAND	670	692

CODED

MAR 24 1971

MISS. BD. OF
WATER COMM.

(8) how well bottom plugged:
Back Pressure Valve

DRILLERS REMARKS:


If well telescopes please sketch and show depths.

GROUND LEVEL

105' - 4" CASING

567' - 2" CASING

20' - 2" SCREEN

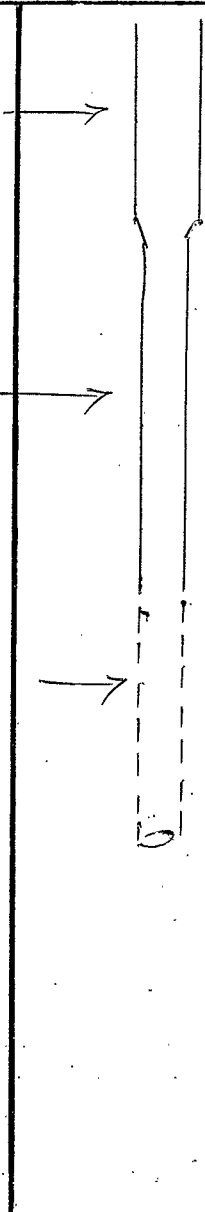

			X

SECTION 31

Please indicate well location X.

ADDITIONAL INFORMATION

If more than one screen, show locations of each on sketch.