

GW 4810
SE/NW, Sec. 27
Elev. 140

SUNFLOWER
C37
4-16-74

MISSISSIPPI
BOARD OF WATER COMMISSIONERS
416 North State Street
Jackson, Mississippi 39201

WATER WELL DRILLERS LOG

CODED

DYER WELL & IRRIGATION SERVICE

SUNFLOWER

April 16 1974 date well completed
Dyer Well & Irrigation Service firm name
Sunflower county well located

LANDOWNER:

W. O. SHARDEN

description of formations encountered

from to

CLAY

0 18

DREW, MISS.
(mailing address)

FINE SAND

18 32

SAND & PEPPER SAND

32 44

LOOSE SAND

44

PEPPER ROCK

110'

WELL LOCATION:

sec. 27 T23 N R 4 E
S 1/2 miles N.W. of DREW
(distance) (direction) (nearest town)

WELL PURPOSE: IRR.
(home, irrigation, municipal, industrial)

WELL COMPLETION DATA:

- (1) diameter (inches) 16"
- (2) total depth (feet) 110'
- (3) static water level (feet) 20' below top of ground.
- (4) casing PURC 70'
(material) (depth)
16" (size) if telescope see back.
- (5) screen 40' 70'
(length) (depth to top)
16" (size) BUR ZINBIT (material)
- (6) pump 40 2000
(HP) (yield gpm)
DIESEL (type power)
- (7) electric log NO
(yes or no)

CODED

(organization running log)

(8) how well bottom plugged PLATE


DRILLERS REMARKS:

NOV 21 1974

MISS. BD. OF WATER

If well telescopes please sketch and show depths.

GROUND LEVEL

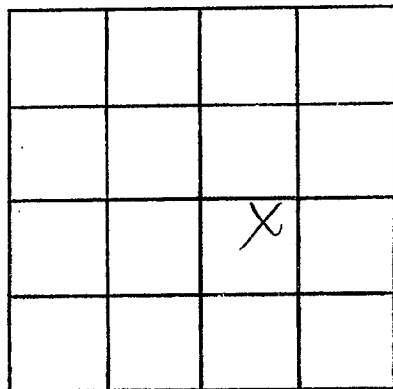

SECTION 27

Please indicate well location X.

ADDITIONAL INFORMATION

If more than one screen,
show locations of each on sketch.