

Sunflower
 C 39
 9-17-68

MISSISSIPPI
 BOARD OF WATER COMMISSIONERS
 416 North State Street
 Jackson, Mississippi 39201

WATER WELL DRILLERS LOG

9/17 1968 W. D. Howard & Son, Inc. Sunflower
 date well completed firm name county well located

LANDOWNER:

W. E. LaMonte Jr.
R. F. D. Drew, Miss.
 (mailing address)

description of formations encountered

from to

Top Soil	0	23
Gravel	23	63
Sand & gravel	63	143
Gravel	143	163
Shall & gravel	163	183
Shall & gravel	183	243
Gravel	243	282
Cl & shale	282	303
Gravel	303	403
Cl & shale	403	443
Gravel	443	563
Sand & shale	563	680

WELL LOCATION:

sec. 9 T. 23 N. R. 4 E.
6 miles North West of Drew
 (distance) (direction) (nearest town)


WELL PURPOSE:

Home
 (home, irrigation, municipal, industrial)

WELL COMPLETION DATA:

- (1) diameter (inches) 4 X 2
- (2) total depth (feet) 672
- (3) static water level (feet) 32 below above top of ground.
- (4) casing steel (material) (depth)
- (size) if telescope see back.
- (5) screen 20 ft (length) (depth to top)
2 1/4 (size) stainless steel (material)
- (6) pump 1/2 HP 18 (HP) (yield gpm)
Elec (type power)
- (7) electric log (yes or no)
 (organization running log)
- (8) how well bottom plugged B.P. Plug

DRILLERS REMARKS:

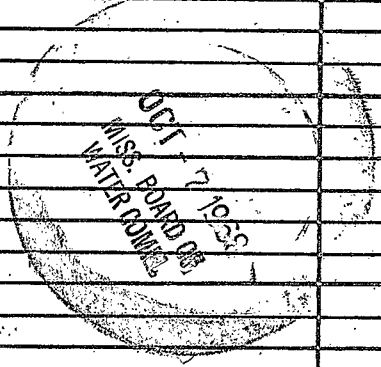

If well telescopes please sketch and show depths.

GROUND LEVEL

4" 130 ft
2" 100 ft
2" 100 ft

		X	

SECTION 7

Please indicate well location X.

ADDITIONAL INFORMATION

If more than one screen, show locations of each on sketch.