

Sonflower
 C 40
 5-67

MISSISSIPPI
 BOARD OF WATER COMMISSIONERS
 416 North State Street
 Jackson, Mississippi 39201

WATER WELL DRILLERS LOG

May 11 679 Burtans Gas of Sonflower
 date well completed firm name county well located
Greenwood

LANDOWNER:
OLLICE WILLIAMS SR.
RT-1 - MERIGOLD, MISS
 (mailing address)

description of formations encountered from to


WELL LOCATION:
 sec 34 T 23 N R 4 E
 S W
3 1/2 miles W of DRBW
 (distance) (direction) (nearest town)

WELL PURPOSE: Home
 (home, irrigation, municipal, industrial)

WELL COMPLETION DATA:

- (1) diameter (inches) 4" x 2"
- (2) total depth (feet) 671'
- (3) static water level (feet) 29 below top of ground above
- (4) casing 4" - 105'
2" - 546'
 (material) (depth)
4" x 2" if telescope see back.
 (size)
- (5) screen 20', 651'
 (length) (depth to top)
2", STAINLESS STEEL
 (size) (material).
- (6) pump 1 10
 (HP) (yield gpm)
ELECTRIC
 (type power)
- (7) electric log No
 (yes or no)
 (organization running log)
- (8) how well bottom plugged:
Ball Pressure Valve

N. P. Sand 591 679

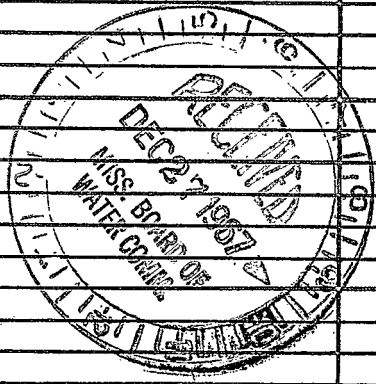

DRILLERS REMARKS:

