

SUNFLOWER
C 41
3/18/79

MISSISSIPPI BOARD OF WATER COMMISSIONERS CODED
416 North State Street
Jackson, Mississippi 39201
WATER WELL DRILLERS LOG

March 18, 1979 *Reherson's Water Wells* *Sunflower*
date well completed firm name county well located

LANDOWNER:
Leon Williams
R-1 B-110
Marigold, Mississippi
(mailing address)

description of formations encountered	depth	
	from	to
<i>Top soil</i>	<i>0</i>	<i>5</i>
<i>Clay</i>	<i>5</i>	<i>15</i>
<i>Fine Red Sands</i>	<i>15</i>	<i>30</i>
<i>Coarse White Sand</i>	<i>30</i>	<i>100</i>

WELL LOCATION:
sec *34* T *23* N S R *4* E W
3 1/2 miles *West* of *Drew*
(distance) (direction) (nearest town)

WELL PURPOSE:
(home, irrigation, municipal, industrial)

- WELL COMPLETION DATA:
- (1) diameter (inches) *8"*
 - (2) total depth (feet) *100'*
 - (3) static water level (feet) *15'* *below* top of ground.
 - (4) casing *PDC*, *14.0 PSI*
(material) (depth)
 - (size) if telescope see back.
 - (5) screen *30'*, *70'*
(length) (depth to top)
 - 8"*, *PDC*
(size) (material)
 - (6) pump *7 1/2*, *500*
(HP) (yield gpm)
 - Electric*
(type power)
 - (7) electric log (yes or no)
 - (organization running log)
 - (8) how well bottom plugged *CAPPED*

DRILLERS REMARKS:


Miss. Board of Water Comm.

MAR 16 1979

RECEIVED

If well telescopes please sketch and show depths.

GROUND LEVEL

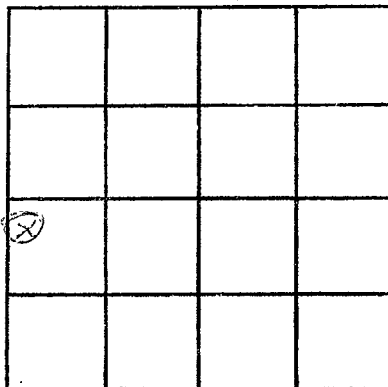

SECTION 34

Please indicate well location X.

ADDITIONAL INFORMATION

If more than one screen,
show locations of each on sketch.