

SUNFLOWER
C42
3/18/79

MISSISSIPPI
BOARD OF WATER COMMISSIONERS
416 North State Street
Jackson, Mississippi 39201

CODED

WATER WELL DRILLERS LOG

March 18, 1979 19 Robison's Water Wells Sunflower
date well completed firm name county/well located

LANDOWNER:	description of formations encountered	from	to
<u>Leon Williams</u> R-1 B-110 <u>Meridian, Mississippi</u> (mailing address)			
<p>WELL LOCATION:</p> <p>sec <u>34</u> T <u>23</u> (N) R <u>4</u> (E) (W)</p> <p><u>3 1/2</u> miles <u>West</u> of <u>Deer</u> (distance) (direction) (nearest town)</p>			
<p>WELL PURPOSE:</p> <p>(home, irrigation, municipal, industrial)</p>			
<p>WELL COMPLETION DATA:</p> <p>(1) diameter (inches) <u>8"</u></p> <p>(2) total depth (feet) <u>100'</u></p> <p>(3) static water level (feet) <u>75</u> <u>below</u> above top of ground.</p> <p>(4) casing <u>PVC</u>, <u>160</u> <u>PST</u> (material) (depth)</p> <p><u> </u> If telescope see back. (size)</p> <p>(5) screen <u>30'</u>, <u>70'</u> (length) (depth to top)</p> <p><u>8"</u>, <u>P.V.C.</u> (size) (material)</p> <p>(6) pump <u>1/2</u>, <u>500</u> (HP) (yield gpm)</p> <p><u>Electric</u> (type power)</p> <p>(7) electric log <u> </u> (yes or no)</p> <p><u> </u> (organization running log)</p> <p>(8) how well bottom plugged <u>CAPPED</u></p>			
<p>DRILLERS REMARKS:</p>			

CODED


Miss. Board of Water Comm.

APR 16 1979

RECEIVED

If well telescopes please sketch and show depths.

GROUND LEVEL

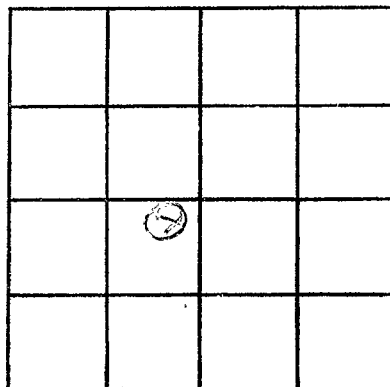

SECTION 34

Please indicate well location X.

ADDITIONAL INFORMATION

If more than one screen,
show locations of each on sketch.